


Section 31 Township 15 Range 15-W


Well No. 1 - Pearson

Company Murfin & Vernon

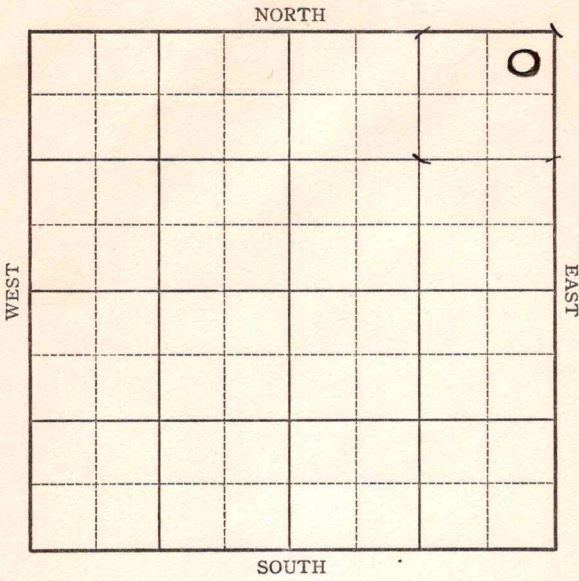

KANSAS

Russell

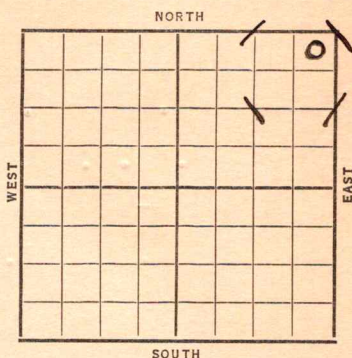Sec. 31 Twp. 15 R. 15-WWell No. #1 Pearson Farm
Marfin & Vernon Company330 Ft. from N. Line Ft. from S. Line330 Ft. from E. Line Ft. from W. Line

Elev. 1908

Date	REPORT
1937	
9/1	Cellar.
9/10	"
9/17	"
9/24	Spud.
10/2	Spud & SD.
10/8	" "
10/15	" "
10/22	" "
10/29	15" @ 343'. Drlg. 450'.
11/5	12" @ 631'. Drlg. 845'.
11/12	Anhy 975'. 10" @ 1000'.
	Drlg. 1720'.
11/19	8" @ 2345'. Drlg. 2405'.
11/26	T.D. 2650'. U. R. 8".
12/3	8" @ 2656'. Topeka 2877'.
	Drlg. 2885'. No shows.
12/10	1½ BW @ 3120'. K.C. 3193'.
	6" @ 3198'. H.F.W. 3230-35'.
	Drlg. 3245'.
	OVER

1937

12/17 Fsg. 3305'.

12/24 Sm. S.O. 3260 & 3290-92 &
3381-83 & 3384-86'.

Drl g. 3421'.

12/29 6" @ 3198'.

Cong. 3421'.

Arb. 3474'.

H.F.W. 3475-80'.

T.D. 3480'.

ABANDONED

KANSAS

Russell

Map No. _____ Sec. 31 Twp. 15 R. 15WWell No. 1- Pearson
Murfin & Vernon Company

Contractor _____

FIRST REPORT

SECTION PLAT

330 Ft. from N. Line

_____ Ft. from S. Line

330 Ft. from E. Line

_____ Ft. from W. Line

Location _____

Rig up _____

Drilling and Remarks:

Cellar

RECORD

Cased _____ in., _____ ft.

Sand _____

Gas _____

Oil _____

Total Depth _____

PRODUCTION

1st 24 hrs. Nat. _____

1st 24 hrs. after shot _____

Gas _____ Cu. Ft.

Dry Hole _____

Abandoned _____

Date

SEP 1 1937 19H. D. Hatfield Scout

Russell **KANSAS**Map No. 73 Sec. 31 Twp. 15 R. 15WWell No. 1 PearsonMurfin & Vernon

Company

Contractor

SECTION PLAT

NE/C

330

Ft. from N. Line

Ft. from S. Line

330

Ft. from E. Line

Ft. from W. Line

ABANDONED

			0

Location _____

Rig up _____

Drilling and Remarks:

CO 19 3421
HFW 3475-80

DVA

RECORD

Cased 6 in., 3198 ft.Sand Arb 347.4

Gas _____

Oil _____

Total Depth 3480

PRODUCTION

1st 24 hrs. Nat. _____

1st 24 hrs. after shot _____

Gas _____ Cu. Ft.

Dry Hole _____

Abandoned _____

Date

DEC 29 1937 19H. D. Hatfield Scout