

KANSAS


Ellis

FORM 51 5M BR1X

Section 35 Township 15 Range 16W

Well No. #2, Gorham

Company Coralena

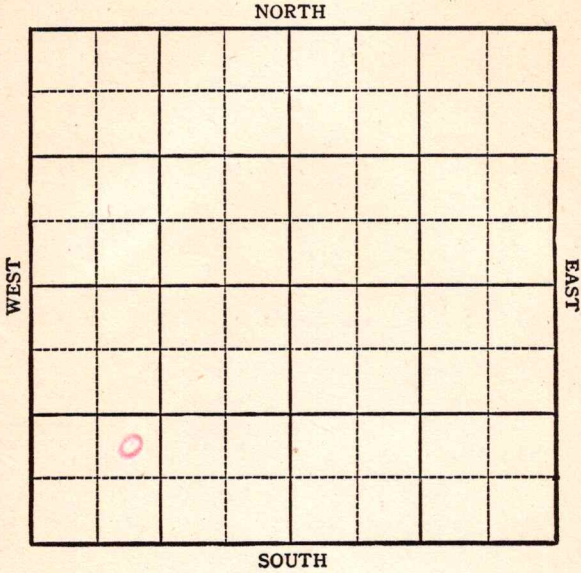

Sec. 35 Twp. 15 R. 16W

Well No. 2 Gorham Farm
Coralena Company


Beeching

_____ Ft. from N. Line

990 Ft. from S. Line

_____ Ft. from E. Line

990 Ft. from W. Line

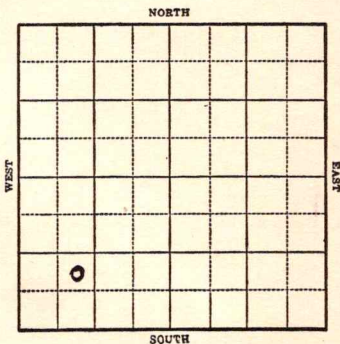

1944

R E P O R T

7/5 Rotary
7/12 10" @ 1014 Drlg 1605
7/19 Lans 3209 Drlg 3247
7/26 Dodge 3199
Arb. 3524-35 TD
7" @ 3330 RUST
8/2 Dodge 3199
Arb 3524-35 TD 7" @ 3330 RUST
8/16 " " " " " " " "
8/23 PB 3360 WOC
8/30 4000 acid testing
9/8 " " "
9-13 Lans. 3209
Arb. 3524
7" @ 3330
PB 3360
2000 acid
Pump 87 oil plus 45% water
36.7 Gr.
TD 3535

COMPLETED

Pool Name Beeching Pool

Map No. 74 Sec. 35 Twp. 15 R. 16W

Well No. 2 Gorham

Coralena Company

COMPLETED Contractor

NE SW SW

SECTION PLAT

_____ Ft. from N. Line

990 Ft. from S. Line

_____ Ft. from E. Line

990 Ft. from W. Line

Ellis County

Location _____

Rig up _____

Drilling and Remarks:

Lane 3209
Ar 3524
7" @ 330
1233 360
2000 acid
Pump 87 oil + 45
362 48

RECORD

Cased _____ in., _____ ft.

Sand _____

Gas _____

Oil _____

Total Depth 3525

PRODUCTION

1st 24 hrs. Nat. _____

1st 24 hrs. after shot _____

Gas _____ Cu. Ft.

Dry Hole *Water*

Abandoned _____

Date

SEP 13 1944

19

S. J. LEWIS

Scout