

Ellis


FORM 51 5M PETROL

KANSAS

Section 18 Township 15 Range 17W

Well No. 1 Schumacker

Company Derby Oil

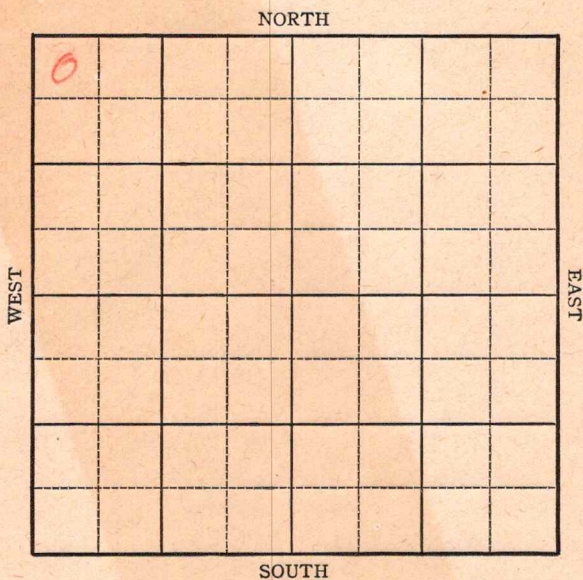

KANSAS

Ellis

Sec. 1 Twp. 15 R. 17-W

Well No. #1 Schumacker Farm

Derby Oil Company

Wildcat


330 Ft. from N. Line

_____ Ft. from S. Line

_____ Ft. from E. Line

330 Ft. from W. Line

NW/c

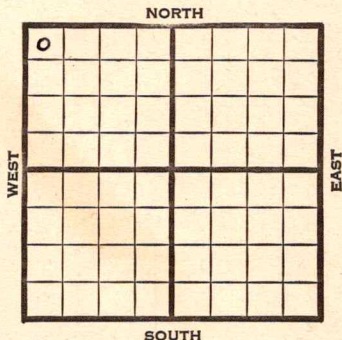

1945 Elev. 1910 REPORT

7/3 Location

7/11 10" @ 257

Drlg. 709

7/19 8" @ 800' WOC

7/26 Drlg. 2484

8/8 Arb. 3495
T.D. 3530'

ABANDONED

KANSASPool Name WildcatMap No. 77 Sec. 1 Twp. 15 R. 17WWell No. 1 SchumackerDerby Oil

Company

FIRST REPORT

Contractor

NW/c

SECTION PLAT330

Ft. from N. Line

Ft. from S. Line

Ft. from E. Line

330

Ft. from W. Line

0			

Ellis CountyLocation X

Rig up

Drilling and Remarks:

RECORD

Cased _____ in., _____ ft.

Sand _____

Gas _____

Oil _____

Total Depth _____

PRODUCTION

1st 24 hrs. Nat. _____

1st 24 hrs. after shot _____

Gas _____ Cu. Ft.

Dry Hole _____

Abandoned _____

Date

JUL 3 1945 19S. J. LEWIS

Scout

Pool Name Wildcat**KANSAS**KansasMap No. 74 Sec. 1 Twp. 15 R. 17WWell No. 1 SchumackerDerby Oil

Company

ABANDONED

Contractor

NW/c

E 1/4 10**SECTION PLAT**

0			

330 Ft. from N. Line

Ft. from S. Line

Ft. from E. Line

330

Ft. from W. Line

Ellis County

Location

Rig up

Drilling and Remarks:

Per 83495**RECORD**

Cased _____ in., _____ ft.

Sand _____

Gas _____

Oil _____

Total Depth 3530**PRODUCTION**

1st 24 hrs. Nat. _____

1st 24 hrs. after shot _____

Gas _____ Cu. Ft.

Dry Hole _____

Abandoned _____

Date

AUG 8 194519S. J. LEWISScout