


Section 9 Township 15 Range 17-W

Well Number #1 Phillips

Company Jones Bros. et al

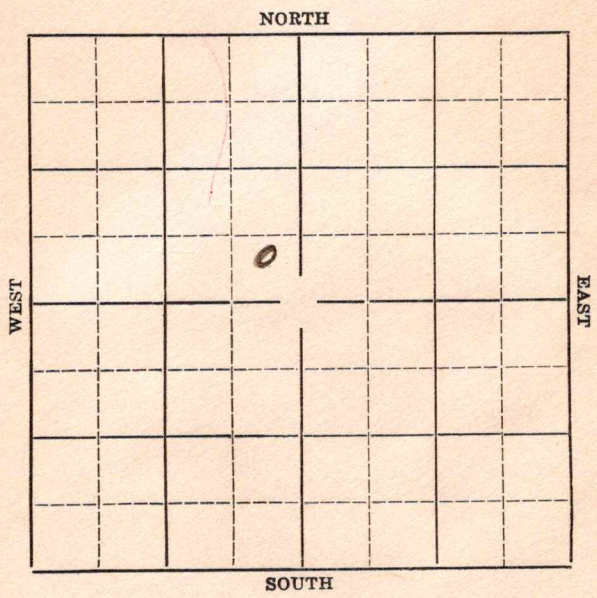

Sec. 9 Twp. 15 R. 17W

Well No. #1 Phillips Farm


Jones Bros. et al Company

_____ Ft. from N. Line

330' Ft. from S. Line

330' Ft. from E. Line

_____ Ft. from W. Line

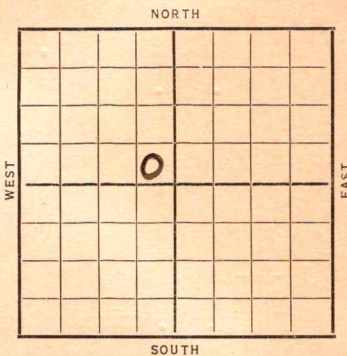

Elev. 1937

Date	REPORT
10/14	Location.
10/22	Rig and tools.
10/29	Rigging. up.
11/6	Drlg. 355
11/12	Lost hole . Skid rig 22' East Rigging up.
11/19	Drlg. 417'.
11/27	12" @ 821' Drlg. 850'.
12/3	Anhy drate 1101'. 10" @ 1108 Drlg. 1210'.
12/10	Drlg. 2140'.
12/17	8" @ 2611'. Drlg. 2760'.
12/24	8" @ 2754'. Drlg. 2855'.
12/29	8" @ 2822'. Drlg. 2985'.
1937	
1/7	Lansing 3245'. 6" @ 3255'. Show oil & water 3314-17'. Hole full water 3445'. Drlg. 3447'.
1/14	Shut down 3493'.
	OVER

1937

1/21 5" @ 3447'. Hole full water.
T. D. 3467' underream 5".

1/27 ---Sil. 3532

T. D. ~~3542~~ 3548

Water

D & A

ABANDONED

Map No. 74 Sec. 9 Twp. 15 R. 17W

Well No. 1 Phillips

Jones Bros et al. Company
Contractor

SECTION PLAT

_____ Ft. from N. Line
330 Ft. from S. Line
330 Ft. from E. Line
_____ Ft. from W. Line

FIRST REPORT

Location ✓

Rig up _____

Drilling and Remarks:

RECORD

Cased _____ in., _____ ft.
Sand _____
Gas _____
Oil _____
Total Depth _____

PRODUCTION

1st 24 hrs. Nat. _____
1st 24 hrs. after shot _____
Gas _____ Cu. Ft.
Dry Hole _____
Abandoned _____

Date

OCT 14 1936₁₉

S. J. LEWIS Scout

Map No. 74 Sec. 9 Twp. 15 R. 17W

Well No. 1 Phillips

Jones Bros & Co Company
Contractor

SECTION PLAT

		0	

_____ Ft. from N. Line
330 Ft. from S. Line
330 Ft. from E. Line
_____ Ft. from W. Line

ABANDONED

Location _____

Rig up _____

Drilling and Remarks:

Oil 3532
Water

DYA

RECORD

Cased _____ in., _____ ft.
Sand _____
Gas _____
Oil _____
Total Depth 3548

PRODUCTION

1st 24 hrs. Nat. _____
1st 24 hrs. after shot _____
Gas _____ Cu. Ft.
Dry Hole _____
Abandoned _____

Date

JAN 27 1937 19

S. J. LEWIS Scout