


KANSAS

Ellis

Section 10 Township 15 Range 17-W

Well No. #1 Phillips

Company Carlock et al

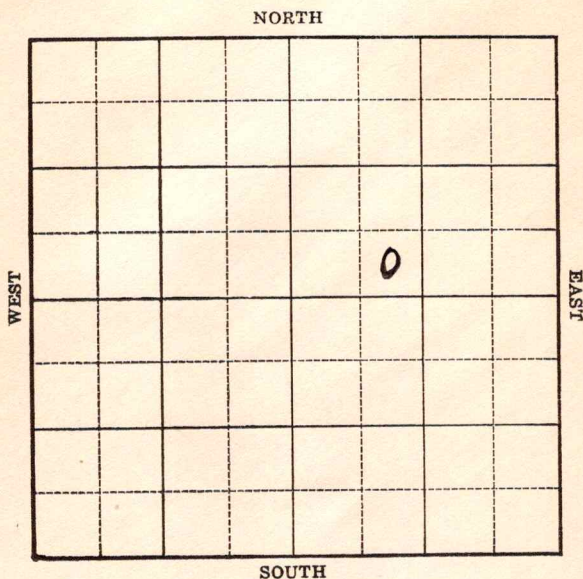


KANSAS

Ellis

Sec. 10 Twp. 15 R. 17-WWell No. #1 Phillips FarmCarlock et al

Company

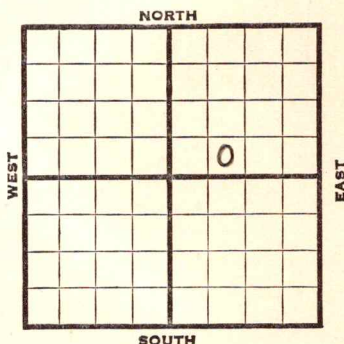 Ft. from N. Line330 Ft. from S. Line Ft. from E. Line990 Ft. from W. Line

Elev. 1911

1938	REPORT
12/7	20" - 40'.
	Drlg. 320'.
12/15	15" - 340'. 12" - 700'.
	Drlg. 750'.
12/23	Anhy 1062'. 10" - 1063'.
	Drlg. 1475'.
12/30	Drlg. 1895'.
1939	
1/6	8" - 2486'. Drlg. 2555'.
1/13	Anhy 1050' (Corrected)
	T. D. 2775'. U. R. 8".
1/20	8" - 2786'. 1 B.W. 3020-25'.
	Drlg. 3075'.
1/27	Lans. 3208'. 1 B.W. 3290'.
	Cherty Cong. 3445'.
	Arb. 3475'. S. W. 3517'.
	T. D. 3519'. HFW. S.D.O.
1/28	Top Arb. 3475'. H. F. W. 3517-19'
	T. D. 3519' (Letter from HDH)

OVER

1939

2/1 7" - 3195'.

Arb. 3475'.

T. D. 3520'.

H.F.W.

ABANDONED

Ellis

KANSAS

Map No. 74 Sec. 10 Twp. 15 R. 17WWell No. 1 PhillipsCarlock etal Company

Contractor

FIRST REPORT

wildcat

SECTION PLAT

SE SW NE

 Ft. from N. Line330 Ft. from S. Line Ft. from E. Line990 Ft. from W. Line

		o	

Location Rig up

Drilling and Remarks:

20" - 40'

Drlg. 320

RECORD

Cased in., ft.Sand Gas Oil Total Depth

PRODUCTION

1st 24 hrs. Nat. 1st 24 hrs. after shot Gas Cu. Ft.Dry Hole Abandoned

Date

DEC 7 - 1938

19

H. D. Hatfield Scout

Ellis

KANSAS

Map No. 74 Sec. 10 Twp. 15 R. 17WWell No. 1 PhillipsCarlock et al

Company

Contractor

ABANDONED

SE SW NE

 Ft. from N. Line330 Ft. from S. Line Ft. from E. Line990 Ft. from W. Line

SECTION PLAT

WILDCAT

Location Rig up

Drilling and Remarks:

HFW

D & A

RECORD

Cased 7 in., 3195 ft.Sand ARB 3475Gas Oil Total Depth 3520

PRODUCTION

1st 24 hrs. Nat. 1st 24 hrs. after shot Gas Cu. Ft.Dry Hole Abandoned

Date

FEB 1 - 1939

19

H. D. Hatfield Scout