


Section 13 Township 15 Range 17 W

Well No. # 1 Kippes

Company Musgrove

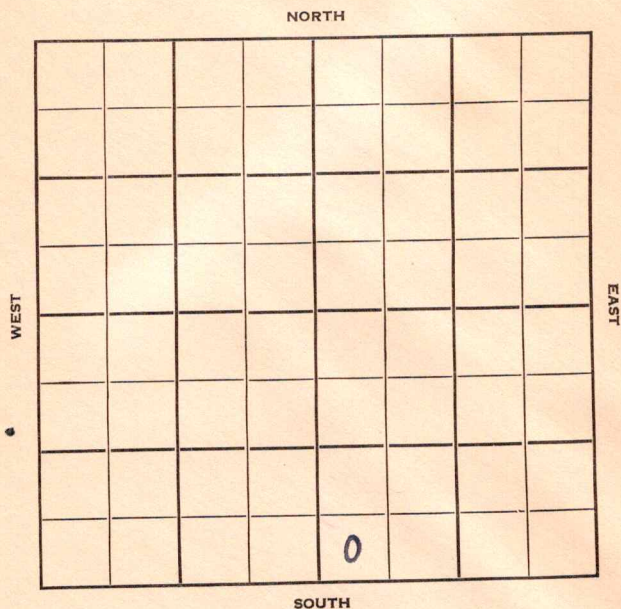

Ellis

KANSAS



Sec. 13 Twp. 15 R. 17 W

Well No. # 1 Kippes Farm

Musgrove Company

Contractor

Wildcat


Ft. from N. Line

330 Ft. from S. Line

Ft. from E. Line

330 Ft. from W. Line

SW SW SE
Magnolia Farmout

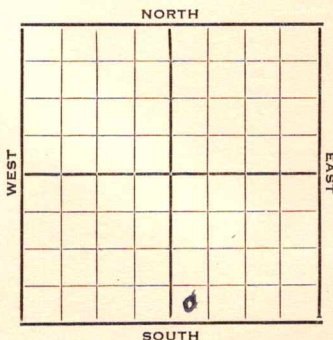

1952

Elev. 1954'

REPORT

9/10

Location

9/17

Anhy 1122' 8" @ 1128

Drlg. 2740'

9/24

Topeka 2970' Heeb 3198' Tor 3215'

Lans. 3249'

Drlg. 3595'

10/1

Spud 9-10-52

D & A TD 3596' Anhy 1122'

8" @ 1128 Top 2970' Heeb 3198'


Tor. 3215' Lans. 3249' Cong 3496'

Arb. 3536' TD 3596'

DST 3536-41 open 1 hr. rec 23' W & OCM

760# D & A

ABANDONED

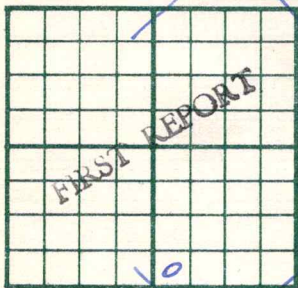County Ellis State KansasSec. 13 (Blk. Twp.) 15 (Sur. Rge.) 17W Map No.Operator MusgroveWell No. 1 Farm KippesElev. _____ Location SW SW SE330 Ft. From S Line SE330 Ft. From W Line Quarter1st. Report SEP 10 1952

Completion _____


Remarks _____

Magnolia - FO

Spudding Date _____

Drlg. Data WildcatLocation

J. G. McGEHEE

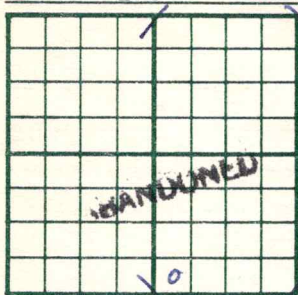County Ellis State KansasSec. 13 (Blk. 15 (Sur. 17W Map No.)
(Twp.) (Rge.)Operator Musgrove Pet.Well No. 1 Farm KippesElev. 1954 Location SW SW SE330 Ft. From S Line SE330 Ft. From W Line Quarter1st. Report Completion OCT 1 1952Remarks WildcatSpudding Date 9-10-52Drlg. Data D & A TD 3596Anhy 1122 8" @ 1128 Top. 2970Heeb. 3198 Tor. 3215 Lans. 3249Cong. 3496 Arb. 3536 TD 3596DST 3536-41 open 1 hr. Rec. 23' w & ocm
760#D & A