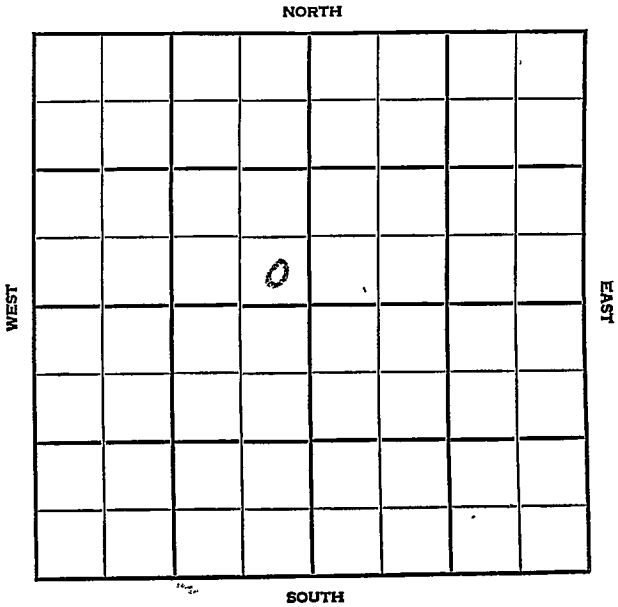


Section 33 Township 31 Range 7 EWell No. #1 Kraft & KelsoCompany Fred Ayesh Oil

Cowley

KANSAS

SEC.	TWP.	R
33	31	7E

WELL NO.

#1 Kraft & Kelson

FARM

COMPANY

Fred Ayesh Oil

CONTRACTOR

Smitherman

WILDCAT


Ft. from N. Line

Ft. from S. Line

Ft. from E. Line

Ft. from W. Line

SE SE NW

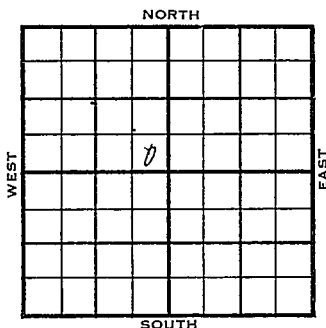SDX $\frac{1}{2}$ mile

1956	ELEVATION	REPORT
	1247'	
2-22	Comm. 2-18-56 8" @ 92/75	
3-1	Br. Lime 1555, Stal. 1610, Layton an. 1996 Layton sd. 2040 DST 2040-52, op 2 hrs. 1200' gas, rec. 72' gcm, 430/30" 5 $\frac{1}{2}$ " @	
3-8	4 $\frac{1}{2}$ " @ 2061 CO, 18/2042-45, frac S/load	
3-15	S/ 2 boph, 30% wtr., 12 hrs.	
3-22	No report	
3-29	P/ 2 bopd, 11 bw	
4-5	No report	
4-12	P/ 2 bo, 9 bw, temp. abd.	
4-19	No report	
4-26	"	
5-3	"	
5-10	"	
5-16	Temp. abandoned. TD 2062'	

ABANDONED

County Cowley Elev. _____
 Sec. 33 Twp. 31 Rge. 7E
 Company Fred Wyesh Oil
 FarmName Kraft & Kelso No. 1

TOPS	DEPTH	LOG	DATUM	Loc. in Sec.
Anh.				SE SE NW
TP.				
H.				
Tr.				
Dg.				
BL.				
L.				
K.C.				Geol. _____
B.K.C.				Contr. _____
Ce.				Smitherman
C.				
M.				Pool _____
M.				Wildcat
K.				
Mz.				
Mq.				
V.				
S.				
S.				
A.				
R.				
PE.				
G.				
T.D.				

FEB 22 '56
0
FIRST REPORT
1/2 mile

Date Comm. 2-18-56
8th @ 92/75

Co.

Lse.

No.


Sec.

T.

R.

County Cowley Elev. 12 47
 Sec. 33 Twp. 31 Rge. 7E
 Company Fred Ayesh Oil
 Farm Name Kraft & Kelso No. 1

TOPS	DEPTH	LOG	DATUM	Loc. in Sec.
Anh.				SE SE NW
Tr.				
H.				
Tr.				
Dg.				
BL.	1555			
L. <u>Stal</u>	1610			
K. <u>Stanton</u>	1996			Geol.
BKG. <u>St</u>	2040		79.3	Contr.
Ce.				Smitherman
C.				
M.				
M.				Pool
K.				
Mz.				
Mq.				
V.				
S.				
S.				
A.				
R.				
Pe.				
G.				
TD.	2062			

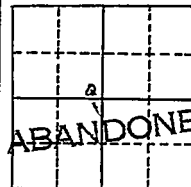

Date Comm. 2-18-56 MAY 16 1956

8" @ 92/75 DST 2040-52 open 2 hr.

1200' gas 72' gcm 430/30"

4 1/2" @ 2061 CO 18/ 2042-45 frac

S/ 2 boph 30% wtr. 12 hr.

P/ 2 bopd 11 bw Temp. abd.