

Map No. K Sec. 25 Twp 28 R. 5
 Well No. 2 Hill Farm
Johnson et al Company

NORTH

0							

SOUTH

WEST

EAST

Location _____

Drilling Remarks:

Rig Up _____

Drilling Remarks:

RECORD

Cased _____ in. _____ ft.

Sand _____

Gas _____

Oil _____

Total Depth _____

PRODUCTION

1st 24 hrs. Nat. _____

1st 24 hrs. after shot _____

Gas _____ cu. ft.

Dry Hole _____

Abandoned _____

Map No. _____ Sec. 25 Twp. 28 R. 5

Well No. 2 Hill Farm _____
Johnson et al Company


NORTH

200 Ft. from N. Line

_____ Ft. from S. Line

_____ Ft. from E. Line

200 Ft. from W. Line

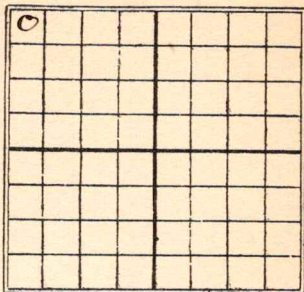

SOUTH

Date 1/4/48

REPORT

1/15 Rig
2/4 ✓
3/30 Dlg 2300'
5/6 2-Sand 2734-2801
Shot 20 gals 300 bbls.

THE PURE OIL COMPANY




200' from N. NORTH 200' from W.

0							
---	--	--	--	--	--	--	--

NORTH

First Report

WEST

EAST

SOUTH

Location _____

Rig up _____

Drilling and Remarks:

Rig

RECORD

Cased _____ in., _____ ft.

Sand _____

Gas _____

Oil _____

Total Depth _____

PRODUCTION

1st 24 hrs. Nat

1st 24 hrs. after shot

Gas _____ Cu. ft.

Dry Hole _____

Abandoned

Date _____

1/13 192 2

M.B.

Scout

Map No. K 11 Sec. 25 Twp. 28 R. 5Well No. 2 HueJohnson et al Company

Contractor

SECTION PLAT

200 Ft. from N. Line

Ft. from S. Line

Ft. from E. Line

200 Ft. from W. Line

0			

COMPLETED

Location

Rig up

Drilling and Remarks:

Land 2734-2801shot 20 ft300 ft

RECORD

Cased _____ in., _____ ft.

Sand _____

Gas _____

Oil _____

Total Depth _____

PRODUCTION

1st 24 hrs. Nat. _____

1st 24 hrs. after shot _____

Gas _____ Cu. Ft.

Dry Hole _____

Abandoned _____

Date

MAY 6 1922

M. A. BENEAR

191

Scout