


Section 35 Township 31 Range 7 E

Well No. #1 Gatton

Company Texas Co.

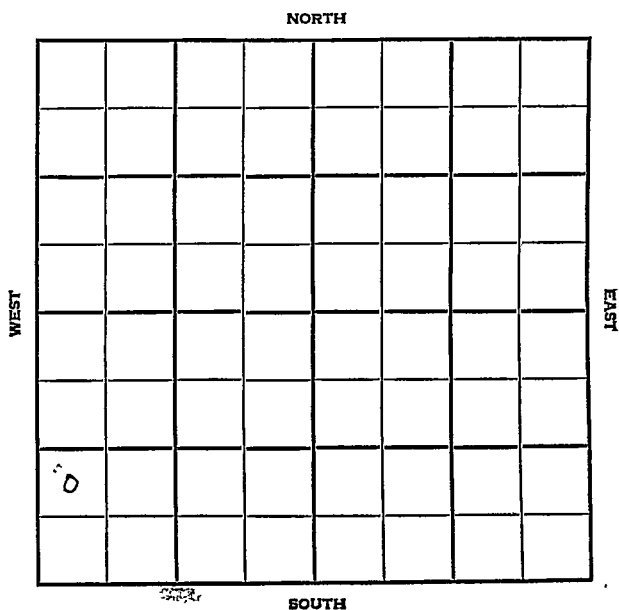

Cowley

KANSAS


SEC.	TWP.	R.
35	31	7 E

WELL NO. # 1 Catton FARM

COMPANY Texas Company

CONTRACTOR Capitt  
Wildcat

\_\_\_\_\_ Ft. from N. Line  
 \_\_\_\_\_ Ft. from S. Line  
 \_\_\_\_\_ Ft. from E. Line  
 \_\_\_\_\_ Ft. from W. Line

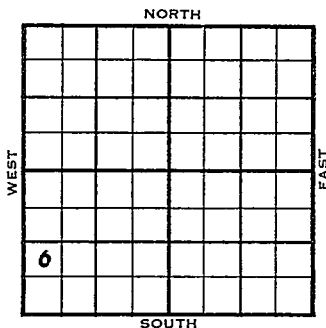

NW SW SW

SDX - 1/2 Mile

	ELEVATION	REPORT
1955	<del>13</del> 1406	

10/12 Comm. 10-5-55  
 10" @ 127 w/110  
 KC 2117', Layton 2122', Layton  
 Lime 2192', Layton Chert 2198'

10/19 Comm 10-5-55  
 10" @ 127/110  
 L 1870  
 KC 2117  
 Layton 2122  
 Layton lime 2192  
 Layton chert 2198  
 Cleve 2431  
 Cong 2436  
 TD 2492  
 DST 2336-61 open 1 hr  
 Rec 160' salty mud 800/30"  
 DST 2428-92 open 1 hr rec 150' mw  
 192/15"  
 D & A

**ABANDONED**

County Cowley Elev. 1406  
 Sec. 35 Twp. 31 Rge. 7E  
 Company Texas Company  
 FarmName Gatton No. 1

TOPS	DEPTH	LOG	DATUM
Anh.			
Tr.			
H.			
Tr.			
Dg.			
Bl.			
L.			
K.C.	2117		
B.K.C.			
Ce. <u>Layton</u>	2122		
C. <u>W. Lame</u>	2192		
M. <u>Chert</u>	2198		
M.			
K.			
Mz.			
Mq.			
V.			
S.			
S.			
A.			
R.			
PE.			
G.			
T.D.			

Loc. in Sec. NW SW SW

Geol. \_\_\_\_\_

Contr. Capitt

Pool Wildcat

*SDX*

*1/2-11-114*  
**FIRST REPORT**  
 OCT 12 '55

Date Comm. 10-5-55  
10" @ 127/110

Co.  
Lse.  
No.  
Sec.  
T.  
R.

County Cowley Elev. 1406  
 Sec. 35 Twp. 31 Rgs. 7E  
 Company Texas Company  
 Farm Name Gatton No. 1

TOPS	DEPTH	LOG	DATUM
Anh. #			
Tp. #			
H.			
Tr.			
Dg.			
Bl.			
L.		1870	464
K.C.	2117		711
B.K.C.			
C. <u>Lauston</u>	2122		716
C. <u>" Mine</u>	2192		786
M. <u>" chest</u>	2198		792
M.			
K. <u>(Vases)</u>		2431	1025
Mz. <u>Case</u>		2436	1030
Mo.			
V.			
S.			
S.			
A.			
R.			
PE.			
G.			
T.D.	2492		

Loc. in Sec. NW SW SW  
 Geol. \_\_\_\_\_  
 Contr. \_\_\_\_\_  
 Capitt \_\_\_\_\_  
 Pool \_\_\_\_\_  
 Wildcat \_\_\_\_\_


**ABANDONED**

Date Comm. 10-5-55 OCT 19 1955

10" @ 127/110 DST 2336-61 open 1 hr.  
 Rec. 160' salty mud 800/30"  
 DST 2428-92 open 1 hr. rec. 150' mw  
 192/15"

D & A

Co.  
 Loc.  
 No.  
 Sec.  
 T.  
 R.