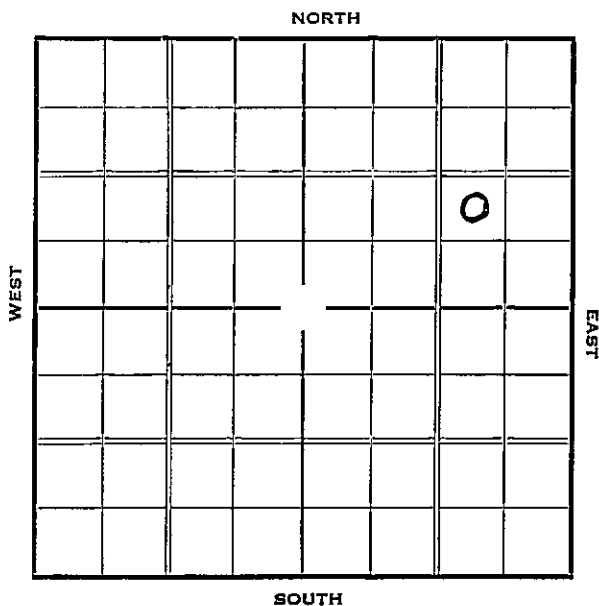


Section 36 Township 15 Range 14-WWell Number 6 - DeinesCompany Corolena

Map No. _____ Sec. 36 Twp. 15 R. 14WWell No. 6-DeinesCoralena Company

Contractor _____

FIRST REPORT

SECTION PLAT

			0

_____ Ft. from N. Line

990 Ft. from S. Line990 Ft. from E. Line

_____ Ft. from W. Line

Location _____

Rig up _____

Drilling and Remarks:

RR

RECORD

Cased _____ in., _____ ft.

Sand _____

Gas _____

Oil _____

Total Depth _____

PRODUCTION

1st 24 hrs. Nat. _____

1st 24 hrs. after shot _____

Gas _____ Cu. Ft.

Dry Hole _____

Abandoned _____

Date

SEP 8 1927

19

H. D. Hatfield

Scout

Russell KANSAS

Map No. _____ Sec. 35 Twp. 15 R. 14WWell No. 6 DeinesCoralena Company

Contractor

COMPLETED

NW SE NE

SECTION PLAT

			0

92 Ft. from N. Line990 Ft. from S. Line990 Ft. from E. Line

_____ Ft. from W. Line

Location _____

Rig up _____

Drilling and Remarks:

2000 AcidPOT-2939

RECORD

Cased 8 in., 3271 ft.Sand 511 3271

Gas _____

Oil _____

Total Depth 3273

PRODUCTION

1st 24 hrs. Nat. _____

1st 24 hrs. after shot _____

Gas _____ Cu. Ft.

Dry Hole _____

Abandoned _____

Date

OCT - 6 1937E. D. Hatfield Scout