

Section 36 Township 31 Range 7EWell No. #1 HoughCompany Time Pet.

NORTH

WEST

EAST

SOUTH

0

6owley


NSAS

SEC.	TWP.	R.
36	31	7E ✓

WELL NO. #1 Hough FARM

COMPANY Time Pet.

CONTRACTOR Kriswell

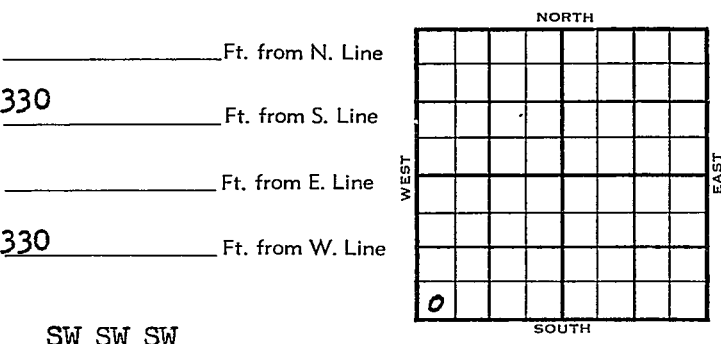

1954 ELEVATION 1424' REPORT

1/13 Spud 1-10-54
8" @ 64'
WOC

2/3 Spud 1-10-54
D & A
TD 2959'
8" @ 64'
Stal 1719', Lans 1869', KC 2103'
Layton 2112'
DST 2390'-2500' opn 1 hr, rec 30' Mud
Oswego 2587', Bart 2680', Miss 2926'
TD 2959'
D & A

ABANDONED

County Geary State Kansas

Sec. **36** (Blk. **31** (Sur. **7E** Map No.

Operator Time Pat

Well No. 1 Farm Hough

Elev.	Location	SW	SW	SW
-------	----------	----	----	----

FIRST REPORT

330 Ft. From S Line STH

	Ft. From	Line	Quarter
530			

1st. Report JAN 13 1954

Completion

Remarks


Kriswell - Contr.

Spudding Date 7-10-54

Drlq. Data

8" @ 64 WOC

County Cowley State Kansas
 Sec. 36 (Blk.) 31 (Sur.) 7E Map No.
 Operator Time Pet.
 Well No. 1 Farm Hough
 Elev. 1424 Location SW SW SW

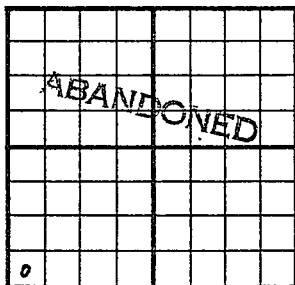

330 Ft. From S Line SW
330 Ft. From W Line Quarter

1st. Report

Completion FEB 3 1954

Remarks

Kriswell - Contr.

Spudding Date 1-10-54

Drlg. Data D & A TD 2959

8" @ 64 Stal. 1719 Lans. 1869

KC 2103 Layton 2112 DST 2390-2500

open 1 hr. Rec. 30' mud Oswego 2587

Bart. 2680 Miss. 2926 TD 2959

D & A

J. G. McGEHEE