


Map No. 11 Sec. 25 Twp. 28 R. 5
 Well No. 1 Bomper Farm
Inland Drains Company

NORTH

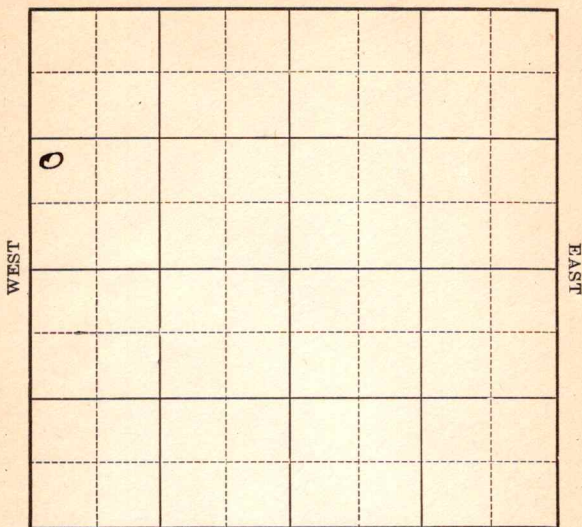

SOUTH

COMPLETED

Location

Drilling Remarks:

.....

.....

RECORD

Cased in. ft.

Sand

Gas

Oil

Total Depth

Rig Up

Drilling Remarks:

.....

.....

PRODUCTION

1st 24 hrs. Nat.

1st 24 hrs. after shot

Gas cu. ft.

Dry Hole


Abandoned

Map No. 11 Sec. 25 Twp. 28 R. 5

Well No. 1 Bowyer Farm
Inland & Davis Company

NORTH

Ft. from N. Line

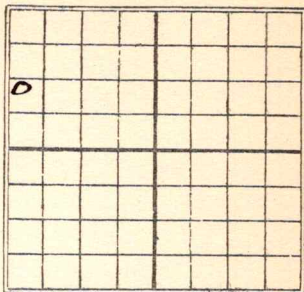

1120 Ft. from S. Line

Ft. from E. Line

200 Ft. from W. Line

SOUTH

Date

REPORT

1922

1/3

Gas 2765 - Del 2773 -
2823 - 100 bbls net -
Shot 20 gts 150 bbls

Map No. 11 Sec. 25 Twp. 28 R. 5Well No. 1 Bowyer FarmIreland & McKinnis, CompanyDate Started _____ Ft. from N. S 120' E W 20' lineNORTH Kansas

WEST

FIRST REPORT

EAST

SOUTH

Cased _____ In. _____ Ft.

Sand _____

Production Remarks

Pay

{ Gas 2765{ Oil 2773-2823

Total Depth _____

100 lbs mat,
shot 20 gto
150 lbs, after
shot.

Condition of Well on this date _____

Completed.

M. A. BENEAR

Scout