


Section 34 Township 15 Range 15-W


Well Number 1 Stienert Estate

Boyle Grossman Dlg.
Company ~~Goldstine & Vernen Oil &~~
Gas

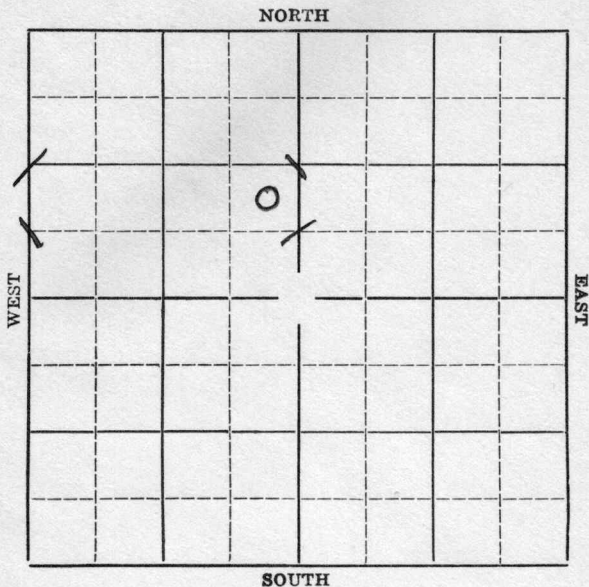

Sec. 34 Twp. 15 R. 15-WWell No. #1 Stienert Estate Farm~~Goldstine & Vernon Oil & Gas Company~~Boyle Grossman Drlg. Co. Ft. from N. Line990 Ft. from S. Line330 Ft. from E. Line Ft. from W. Line

Elev. 1937

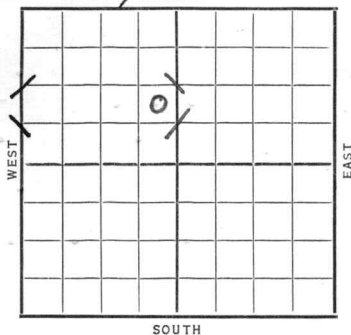Date
1937

REPORT

3/3

R O G

3/11

" "

3/18

" "

3/25

"

4/2

Rig.

4/8

Rig & tools

4/16

Spud S.D.

4/23

15" @ 297'. Drlg. 300'.

4/30

Drlg. 615'.

5/7

C.O. 830'.

5/14

Anhy 960'. 10" @ 961'.

T.D. 1130' SD.

5/21

Drlg. 1590'.

5/28

Drlg. 2230'.

6/4

8" @ 2356'. Drlg. 2465'.

6/11

8" @ 2623'. Drlg. 2675'.

6/19

Drlg. 2820'.

6/25

SD @ 2835'.

7/2

" "

7/9

8" @ 2820'. Drlg. 2880'.

7/16

Topeka 2885'. Drlg. 3150'.

OVER

1937

7/23 6" @ 3174'. Lans. 3178'.
H.F.W. 3195-3200'.
Drlg. 3221'.

7/30 6" @ 3262'. Drlg. 3272'.

8/6 Sil. 3442'. H.F.W. 3455-60'. S.D.O.

8/11 6" @ 3262'.
Sil. 3442'.
T.D. 3460'.
H.F.W. 3455-60'.
D & A

ABANDONED

KANSAS

Map No. 73 Sec. 34 Twp. 15 R. 15W.Well No. 1 Stienert EstateGoldstine & Vernon Oil & Gas Company

Contractor _____

SECTION PLAT



_____ Ft. from N. Line

990 Ft. from S. Line330 Ft. from E. Line

_____ Ft. from W. Line

FIRST REPORT

Location _____

Rig up _____

Drilling and Remarks:

ROG

RECORD

Cased _____ in., _____ ft.

Sand _____

Gas _____

Oil _____

Total Depth _____

PRODUCTION

1st 24 hrs. Nat. _____

1st 24 hrs. after shot _____

Gas _____ Cu. Ft.

Dry Hole _____

Abandoned _____

Date

MAR 3 1937

19

S. J. LEWIS Scout

Russell

Map No. _____ Sec. 34 Twp. 15 R. 1514Well No. 1 Stienert EstateBoyle Grossman Drig. Company

Contractor

SECTION PLAT

	0		

_____ Ft. from N. Line

990 Ft. from S. Line330 Ft. from E. Line

_____ Ft. from W. Line

CORRECTION

Location _____

Rig up _____

Drilling and Remarks:

Reported as.
Goldstone & Vernon
O & G.

Boyle & Grossman
Drig Co are going
to operate it

RECORD

Cased _____ in., _____ ft.

Sand _____

Gas _____

Oil _____

Total Depth _____

PRODUCTION

1st 24 hrs. Nat. _____

1st 24 hrs. after shot _____

Gas _____ Cu. Ft.

Dry Hole _____

Abandoned _____

Date

Mar 8 1937

S. J. LEWIS

Scout

Russell KANSAS

Map No. _____ Sec. 34 Twp. 15 R. 15^wWell No. 1 - Stienert Est.Boyle & Grossman Drilling Company

Contractor

ABANDONED

_____ Ft. from N. Line

990 Ft. from S. Line330 Ft. from E. Line

_____ Ft. from W. Line

SECTION PLAT

	0		

Location _____

Rig up _____

Drilling and Remarks:

HFW

3455-60

D & A

RECORD

Cased 6 in., 3262 ft.Sand 5113442

Gas _____

Oil _____

Total Depth 3460

PRODUCTION

1st 24 hrs. Nat. _____

1st 24 hrs. after shot _____

Gas _____ Cu. Ft.

Dry Hole _____

Abandoned _____

Date

AUG 11 1937₁₉

H. D. Hatfield Scout