


Section 35 Township 15 Range 15-W

Well No. #2 Boxberger "B"

Company Sohio

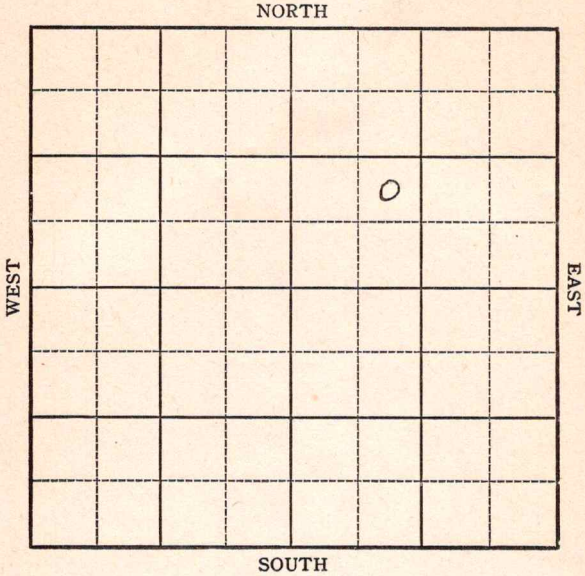


Sec. 35 Twp. 15 R. 15-W

Well No. #2 Boxberger "B" Farm

Sohio Company

NORTH

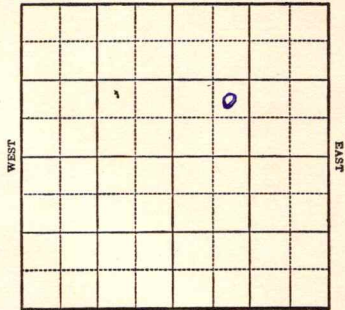

_____ Ft. from N. Line

990 Ft. from S. Line

_____ Ft. from E. Line

990 Ft. from W. Line

Elev. 1912

1943

R E P O R T

- 11/3 Drlg. 722'
- 11/10 **Anhy 923**
10" @ 937
Drlg. 1027'
- 11/17 **Lanc. 3141**
Drlg. 3176'
- 12-1 **Arb 3414**
TD 3425
No shows

ABANDONED

Map No. ^{KANSAS} 75 Sec. 35 Twp. 15 R. 15W

Well No. 2 Boxberger "B"

Sohio Company

FIRST REPORT Contractor

NE SW NE

SECTION PLAT

_____ Ft. from N. Line

990 Ft. from S. Line

_____ Ft. from E. Line

990 Ft. from W. Line

Miscellaneous

Location _____

Rig up _____

Drilling and Remarks:

722'

RECORD

Cased _____ in., _____ ft.

Sand _____

Gas _____

Oil _____

Total Depth _____

PRODUCTION

1st 24 hrs. Nat. _____

1st 24 hrs. after shot _____

Gas _____ Cu. Ft.

Dry Hole _____

Abandoned _____

Date

NOV 3 1943 19

S. J. LEWIS Scout

Map No. KANSAS 3 Sec. 35 Twp. 15 R. 15W

Well No. 2 Boxberger "B"

Sohio Company

ABANDONED Contractor

NE SW NE

SECTION PLAT

		6	

_____ Ft. from N. Line

990 Ft. from S. Line

_____ Ft. from E. Line

990 Ft. from W. Line

Miscellaneous

Location _____

Rig up _____

Drilling and Remarks:

See # 3414

No show

RECORD

Cased _____ in., _____ ft.

Sand _____

Gas _____

Oil _____

Total Depth 3425

PRODUCTION

1st 24 hrs. Nat. _____

1st 24 hrs. after shot _____

Gas _____ Cu. Ft.

Dry Hole _____

Abandoned _____

Date

DEC 1 1943 19 _____

S. J. LEWIS Scout