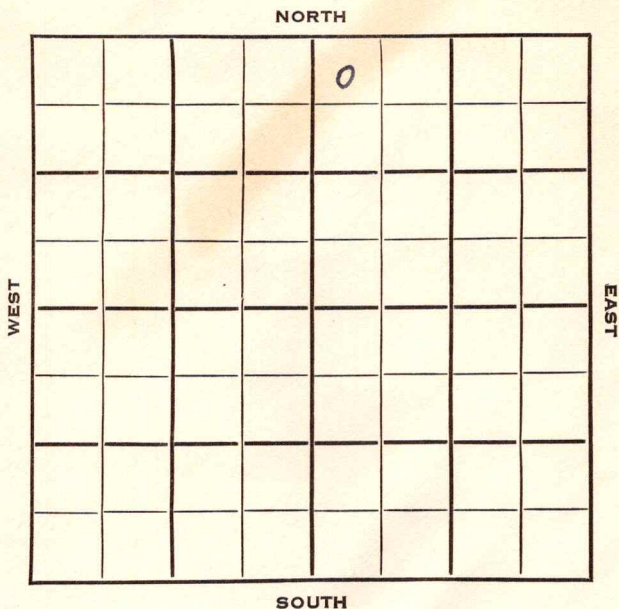


Section 3 Township 15 Range 17WWell No. 1 PhillipCompany Derby Oil

Ellis

KANSAS

SEC.	TWP.	R.
3	15	17 W

WELL NO. # 1 Phillip FARM

COMPANY Derby Oil

CONTRACTOR


Wildcat

330 Ft. from N. Line

Ft. from S. Line

Ft. from E. Line

330 Ft. from W. Line

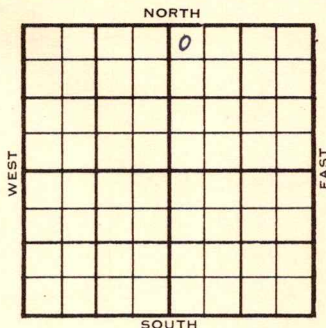

NW NW NE
Texas - DHM

	ELEVATION	REPORT
1954	1953'	

2/24 Location

3/3 8" @ 1104' w/450 sks
Drlg. 2240'

3/10 Spud 2-25-54 D & A TD 3557
8" @ 1104' Anhy 2094' Heeb 3183
Lans. 3231
DST 3298-3326 open 1/2 hr rec 25' wtry.
mud 980#
DST 3373-3407 open 1/2 hr rec 10' mud
150#
Cong. 3466
DST 3490-3505 open 1/2 hr rec 4' rotary
mud. 30# Arb. 3541 TD 3557
Schl tops: Heeb 3182 Lans 3228
Cong. 3493 Arb. 3541
TD 3557 D & A

ABANDONED

County **Ellis** State **Kansas**
Sec. **3** (Blk. **15** (Sur. **17W** Map No.

Operator **Derby Oil**

Well No. **1** Farm **Phillip**

Elev. Location **NW NW NE**

330 Ft. From **N** Line **NE**

330 Ft. From **W** Line Quarter

1st. Report **FEB 24 1954**

Completion

Remarks **Texas - DEM**


Spudding Date

Drlg. Data

Wildcat

Location

J. G. McGEHEE

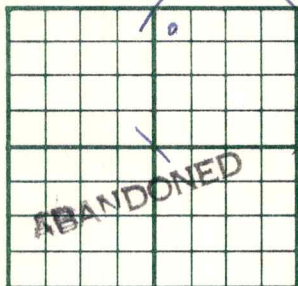County Ellis State KansasSec. 3 (Blk.) 15 (Sur.) 17W Map No.Operator Derby OilWell No. 1 Farm PhillipElev. 1953 Location NW NW NE330 Ft. From N Line NE330 Ft. From W Line Quarter

1st. Report

Completion MAR 10 1954Remarks WildcatSpudding Date 2-25-54Drlg. Data D & A TD 35578" @ 1104 Anhy 1094 Heeb. 3183Lans. 3231 DST 3298-3326 open $\frac{1}{2}$ hr.Rec. 25' wtry mud 980# DST 3373-3407open $\frac{1}{2}$ hr. Rec. 10' mud 150#Cong. 3466 DST 3490-3505 open $\frac{1}{2}$ hr.Rec. 4' rotary mud 30# Arb. 3541TD 3557 SCHLUMBERGER TOPSHeeb. 3182 Lans. 3228 Cong. 3493Arb. 3541 TD 3557D & A

J. G. McGEHEE