

Section 10 Township 15 Range 17 W

Well No. #1 Philip

Company Shelly Miller

NORTH

				0			

WEST

EAST

SOUTH

Ellis

KANSAS

SEC. 19	TWP. 15	R. 17W
------------	------------	-----------

WELL NO. #1 Philip FARM

COMPANY

Shelley-Miller

CONTRACTOR

Co. Tools


WILDCAT

\_\_\_\_\_ Ft. from N. Line

\_\_\_\_\_ Ft. from S. Line

\_\_\_\_\_ Ft. from E. Line

\_\_\_\_\_ Ft. from W. Line

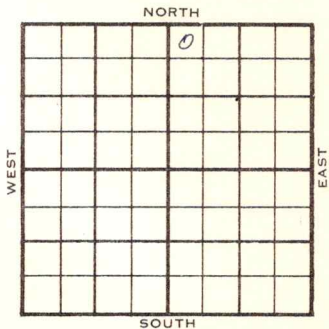

NW NW NE

1956	ELEVATION	REPORT
------	-----------	--------

2-15 MIR

County Ellis Elev. \_\_\_\_\_  
 Sec. 10 Twp. 15 Rge. 17W  
 Company Shelley-Miller  
 FarmName Philip No. 1

TOPS	DEPTH	LOG	DATUM
Anh.			
Tp.			
H.			
Tr.			
Dg.			
B.L.			
L.			
K.C.			
B.K.C.			
Ce.			
C.			
M.			
M.			
K.			
Mz.			
Mq.			
V.			
S.			
S.			
A			
R.			
Pe.			
G.			
T.D.			

Loc. in Sec. NW NW NE  
 Geol. \_\_\_\_\_  
 Contr. Co. tools  
 Pool Wildcat  

0
---

FIRST REPORT

FEB 15 '56

Date Comm. M I R

A

Co.  
Lse.  
No.  
Sec.  
T.  
R.

Col.

County Ellis Elev. 1901 DF  
 Sec. 10 Twp. 15 Rge. 17W  
 Company Shelley-Miller  
 Farm Name Philip No. 1

TOPS	DEPTH	LOG	DATUM	Loc. in Sec.
Anh.	1055			NW NW NE
Tp.				
H.	3141			
Tr.				
Dg.				
Bl.				
L.	3180		1279	Geol.
K.C.				Contr.
BXC.				Co. tools
Ce.	3447		1516	Pool
C.				Wildcat
M.				
M.				
K.				
Mz.				
Mo.				
V.				
S.				
S.				
A.				
R.				
PC.				
G.				
SD	3503			

ABANDONED

FEB 29 1956

Date Comm.

M I R FEB 22 '56 2-15-56 85/8

1061/450 @ 2250 FEB 29 '56

DST 3195 - 3283 45" rec 27'

Md BHP 720 DST 3313 - 720

1hr rec 28' 50' BHP 980

W.S.A.