


Map No. KANSAS Sec. 12 Twp. 31 R. 8^E
Well No. Hazlett Farm
H. K. Mann Company

NORTH

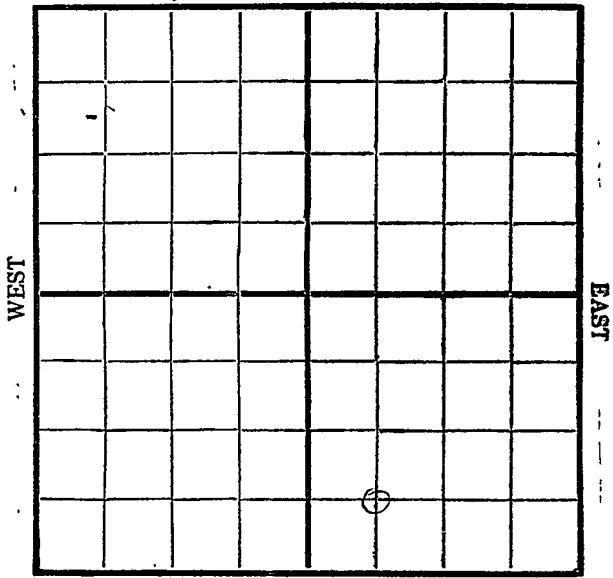

SOUTH

Location _____
Drilling Remarks _____

Rig Up _____
Drilling Remarks _____

RECORD

Cased _____ in. _____ ft.
Sand _____
Gas _____
Oil _____
Total Depth _____

PRODUCTION

1st 24 hrs. Nat. _____
1st 24 hrs. after shot _____
Gas _____ cu. ft. _____
Dry Hole _____
Abandoned _____

Eld

3
Map No. **KANSAS** Sec. *12* Twp. *31* R. *8* ^E

Well No. *1* *Hazlett*

W. K. Mann Company

Contractor

FIRST REPORTS

SECTION PLAT

.....Ft. from N. Line

660 Ft. from S. Line

.....Ft. from E. Line

660 Ft. from W. Line

		o	

Location.....

Rig up.....

Drilling and Remarks:

Rigging up.

RECORD

Cased.....in.,ft.

Sand.....

Gas.....

Oil.....

Total Depth.....

PRODUCTION

1st 24 hrs. Nat.....

1st 24 hrs. after shot.....

Gas.....Cu. Ft.

Dry Hole.....

Abandoned.....

Date

DEC *4* 1929

CHAS. L. SHERWOOD

.....192.....Scout

3 KANSAS

Map No. _____ Sec. 12 Twp. 31 R. 8

Well No. 1 Hazlett

W. K. Mann Company

Contractor

COMPLETE

_____ Ft. from N. Line

660 Ft. from S. Line

_____ Ft. from E. Line

660 Ft. from W. Line

SECTION PLAT

		0	

Location _____

Rig up _____

Drilling and Remarks:

gas well.

RECORD

Cased _____ in., _____ ft.

Sand 1504-1512

Gas _____

Oil _____

Total Depth 1512

PRODUCTION

1st 24 hrs. Nat. _____

1st 24 hrs. after shot _____

Gas 7 1/2 M Cu. Ft.

Dry Hole _____

Abandoned _____

Date
JAN 22 1930

CHAS. L. SHERWOOD