

Section 25 Township 14 Range 15-W

Well No. ~~#8~~ #7 Harbaugh


Company Hartman & Blair

NORTH

11

WEST

EAST

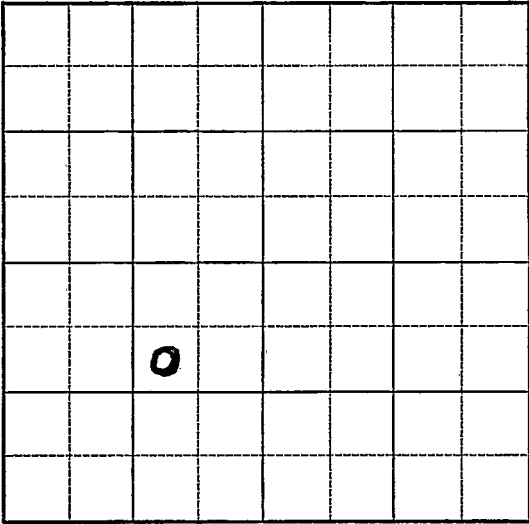


SOUTH



Sec. 25 Twp. 14 R. 15-W

Well No. ~~#8~~ Harbaugh #7 Farm
Hartman & Blair Company

990 Ft. from N. Line
 _____ Ft. from S. Line
990 Ft. from E. Line
 _____ Ft. from W. Line
 Elev. 1743

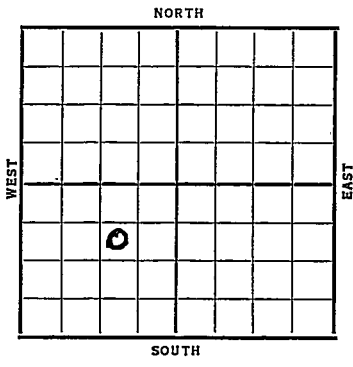

| Date | REPORT |
|-------|------------------------------|
| 1937 | |
| 7/28 | Rig. |
| 8/6 | " |
| 8/13 | R. U. |
| 8/20- | " |
| 8/28 | " |
| 9/3 | " |
| 9/10 | " |
| 9/17 | 15" @ 70'. Drlg. 390'. |
| 9/24 | 12" @ 468'. Anhy 745'. |
| | 10" @ 745'. Drlg. 840'. |
| 10/2 | Drlg. 1825'. |
| 10/8 | Drlg. 2120'. |
| 10/15 | Drlg. 2335'. |
| 10/22 | 8" @ 2446'. Drlg. 2790'. |
| 10/29 | K.C. 2930'. I B.W. 2965-75'. |
| | Oil pay 3080-86'. Rng. 6". |
| 11/5 | " " " " " |
| | |
| | |
| | |
| | |
| | OVER |

1937

11/10 6" @ 3174'.

Gorham 3174'.

T.D. 3184'.

Potential 1898 bbls.

COMPLETED

Map No. _____ Sec. 25 Twp. 14 R. 15^WWell No. S-HarbaughHartman & Blair Company

Contractor

FIRST REPORT

SECTION PLAT

| | | | |
|--|---|--|--|
| | | | |
| | | | |
| | | | |
| | 0 | | |
| | | | |

990 Ft. from N. Line

_____ Ft. from S. Line

990 Ft. from E. Line

_____ Ft. from W. Line

Location _____

Rig up _____

Drilling and Remarks:

Rig

RECORD

Cased _____ in., _____ ft.

Sand _____

Gas _____

Oil _____

Total Depth _____

PRODUCTION

1st 24 hrs. Nat. _____

1st 24 hrs. after shot _____

Gas _____ Cu. Ft.

Dry Hole _____

Abandoned _____

Date

JUL 20 1919H. D. Hatfield

Scout

Russell KANSAS

Map No. _____ Sec. 25 Twp. 14 R. 15 W

Well No. 7-Harbaugh

Hartman & Blair Company

Contractor

CORRECTION

990 Ft. from N. Line

_____ Ft. from S. Line

990 Ft. from E. Line

_____ Ft. from W. Line

SECTION PLAT

| | | | |
|--|--|--|--|
| | | | |
| | | | |
| | | | |
| | | | |

Location _____

Rig up _____

Drilling and Remarks:

*This was originally
given out as #8*

RECORD

Cased _____ in., _____ ft.

- Sand _____

Gas _____

Oil _____

Total Depth _____

PRODUCTION

1st 24 hrs. Nat. _____

1st 24 hrs. after shot _____

Gas _____ Cu. Ft.

Dry Hole _____

Abandoned _____

Date

AUG 25 1937

H. D. Hatfield

19

Scout

Russell KANSAS

Map No. _____ Sec. 25 Twp. 14 R. 15W

Well No. 7 Harbaugh

Hartman & Blair Company

Contractor

COMPLETED
SW NE SW

SECTION PLAT

990 Ft. from N. Line

_____ Ft. from S. Line

990 Ft. from E. Line

_____ Ft. from W. Line

| | | | |
|--|---|--|--|
| | | | |
| | | | |
| | 0 | | |
| | | | |

Location _____

Rig up _____

Drilling and Remarks:

POT 1898

RECORD

Cased 6 in., 3174 ft.

Sand Gorham 3174

Gas _____

Oil _____

Total Depth 3184

PRODUCTION

1st 24 hrs. Nat. _____

1st 24 hrs. after shot _____

Gas _____ Cu. Ft.

Dry Hole _____

Abandoned _____

Date

NOV 10 1937 19

H. D. Hatfield Scout