


DX 78-1 Ellis

KANSAS

Section 15 Township 15 Range 17W

Well No. #1 Roth

Company Tennessee Gas & Trans.

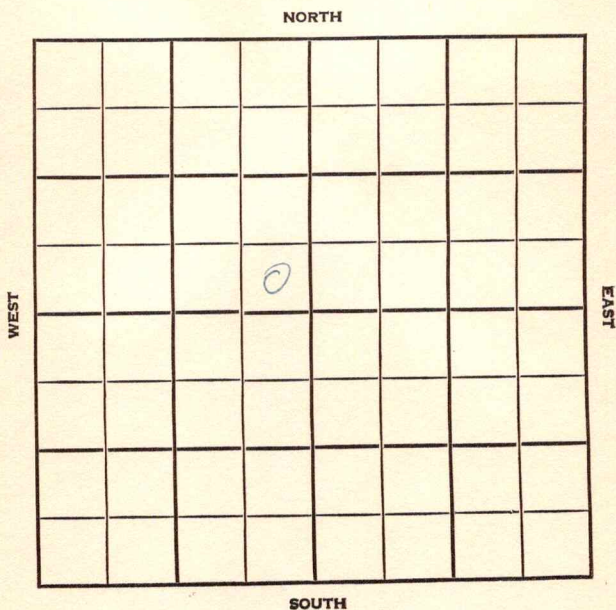

Ellis

KANSAS

SEC. 15	TWP. 15	R. 17W
------------	------------	-----------

WELL NO.

#1 Roth

FARM

COMPANY

Tennessee Gas & Trans.

CONTRACTOR

Shelly-Miller

Degenhart


_____ FT. FROM N. LINE

_____ FT. FROM S. LINE

_____ FT. FROM E. LINE

_____ FT. FROM W. LINE

SE SE NW

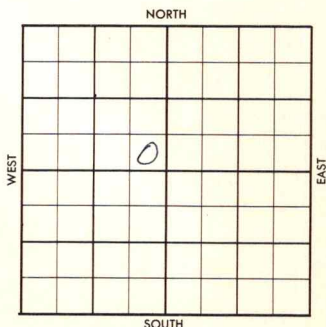

1956	ELEVATION 1967	REPORT
------	-------------------	--------

8-22

Comm. 8-19-56
8" @ 1113 w/450
Anh. 1103'

905

Comm 8-19-56
Tops:
Anh 1103, H 3227, Tr 3248, L 3274,
A 3567,
TD 3597
DST 3362
DST 3562-70 30" rec 9' md
BHP 0
DST 3340-64 1 hr rec 30' md
BHP 1030/20
DST 3436-55 30" rec 30' M
BHP 0
D & A

ABANDONED

County

Ellis

Elev.

Sec.

15

Twp.

15

Rgs.

17W

Company

Tennessee Gas & Trans.

FarmName

Roth

No.

1

TOPS	DEPTH	LOG	DATUM	Loc. in Sec.
Anh.	1103			SE SE NW
TP.				
H.				
Tr.				
Dg.				
BL.				
L.				Geol.
K.C.				Contr.
B.K.C.				Shelly-Miller
Ce.				
C.				
M.				Pool
M.				Degenhart
K.				
Mz.				
Me.				
V.				
S.				
S.				
A.				
R.				
Pe.				
G.				
T.D.				

Date Comm.

8-19-56

8" @ 1113/150

WOC

2201 9 S 01A

14

2.9

County Ellis Elev. 1967
 Sec. 15 Twp. 15 Rgs. 17W
 Company Tennessee Gas & Trans.
 Farm Name Roth No. 1

TOPS	DEPTH	LOG	DATUM	Loc. in Sec.
Anh.	1103			SE SE NW
TP.				
H.	3227			
Tr.	3248			
Dg.				
BL.				
L.	3274			
K.C.				Geol.
B.K.C.				Contr.
Ce.				Shelly-Miller
C.				
M.				Pool
M.				Degenhart
K.				
Mz.				
Mo.				
V.				
S.				
S.				ABANDONED
A	3567			
R.				
Pe.				
G.				
				SEP 5 '56
T.D.	3597			

Date Comm. 8-19-56

8" @ 1113/450 WDC AUG 29 '56 DST 3362

DST 3562-70 30" rec 9' Md

BHYO DST 3340-64 1/4 m 30' Md

BHY 1030/30 DST 3426-55 30" m 30' M

BHYO D & A