

Russell

KANSAS

SECTION 34 TOWNSHIP 15 RANGE 15W

WELL NO. #1 Michaels


COMPANY Helmerich & Payne

NORTH

NW NE SE
SW SE NW

WEST

EAST

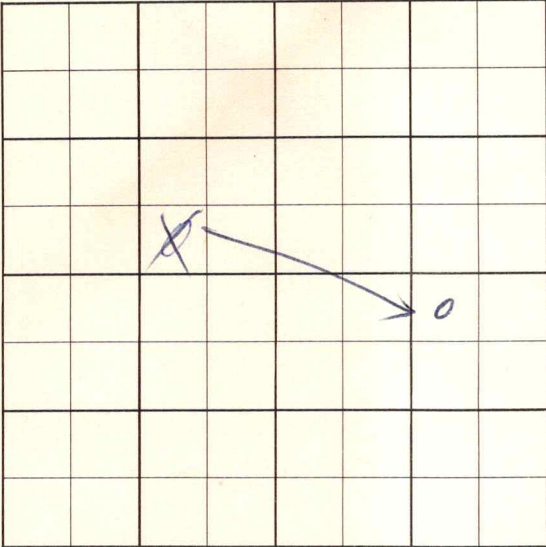

SOUTH

County Russell

Elev. _____

Sec. 34Twp. 15Rge. 15WCompany Helmerich & PayneFarm Name Michael'sNo. 1

Co.

Lse.

No.

Sec.

T.

R.

TOPS

DEPTH

LOG

DATUM

Loc. in Sec. _____

Anh. _____

Tp. _____

H. _____

Tr. _____

Dg. _____

B.L. _____

L. _____

K.C. _____

B.K.C. _____

Ce. _____

C. _____

M. _____

M. _____

K. _____

Mz. _____

Mq. _____

V. _____

S. _____

S. _____

A. _____

R. _____

P.C. _____

G. _____

T.D. _____

SW SE NW

Geol. _____

Contr. _____

Peel Bros.

Pool _____

W. Boxberger

FIRST REPORT	
○	
JUL 10 '57	

Date Comm. _____

Location _____

~~13~~

CORRECTION

FORM 513 SUNRAY

County Russell Elev. 1949
 Sec. 34 Twp. 15 Rge. 15W
 Company Helmerich & Payne
 Farm Name Michaels No. 1

TOPS	DEPTH	LOG	DATUM	Loc. in Sec.
Anh.				NW SE NE
Tr.	3120			NW NE SE
Dg.				
Bl.				
L.				
K.C.	3180			Geol.
B.K.C.				Contr.
Ce.				Peel Bros.
C.				
M.				Pool
M.				W. Boxberger
K.				
Mz.				
Mq.				
V.				
S.				
S.				
A.				
R.				
PE.				
G.				
T.D.	3350			

Date Comm.

Location JUL 17 '57 ✓ JUL 24 '57 JUL 31 '577-28-57 85/8 983/100 WOCAUG 8 '57 C19 @ 3185 AUG 1 '57 AUG 21 '573 1/2 3332/ CO PF 16 1/2 3275-79 Tst 156 WPH+S150. 12P 3264-70 & 6 1/2 BFPH 95% X PB3240 PF 20/3219-24 Tst 106 WPH + S.O. 1/2 X 5BFPH 98% X 205 3205-10 B136 FPH 98% X 205 3184-89-N5. Sq Port 3205-10 3219-24, Co 3193 B 260 pht46W Co Tst AUG 28 '57 CO 3212 20/

3205-10 $1\frac{1}{2}$ 8 27 $\frac{1}{2}$ BFph
 (3.34 Bo) 7 hrs
 Temp Addo

~~Hold For Addo~~

SEP. 4 '37

DCA

34-15-15W

NW NESE