

Elk


Map No. KANSAS Sec. 12 Twp. 31 R. 8

Well No. # 2 ~~#~~ - Schrader Farm

~~H. V. Mann et al~~ Company

BRINEGAR et al

Ft. from N. Line
690
~~660~~ Ft. from S. Line
400
~~660~~ Ft. from E. Line
Ft. from W. Line

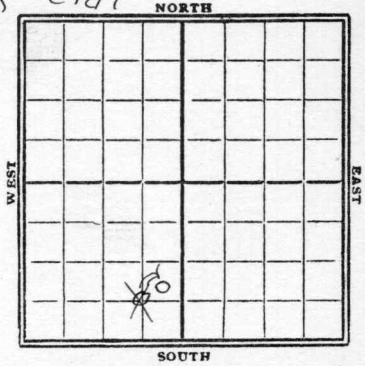

1929

Date	REPORT
2/20	Machine
2/27	Re gw up.
3/16	Dry 700'
3/13	" 900'
3/20	spt'y 8"-900'
3/27	Dry 1450'
4/3	sand 1551-87'
	TD. 1587'
	H A gas
	Pump as gas well

3 *Elk*
 Map No. **KANSAS** Sec. *12* Twp. *31* R. *8*

Well No. *2 Schrader*

Brinegar & Co Company

Contractor

CORRECTION

..... Ft. from N. Line
690 Ft. from S. Line
400 Ft. from E. Line
 Ft. from W. Line

SECTION PLAT

Location.....

Rig up *Log 900'*

Drilling and Remarks:

*Chy location -
 Ownership - and
 Well Number
 was carried as
 M.S. Mann #4*

RECORD

Cased..... in., ft.
 Sand.....
 Gas.....
 Oil.....
 Total Depth.....

PRODUCTION

1st 24 hrs. Nat.....
 1st 24 hrs. after shot.....
 Gas..... Cu. Ft.
 Dry Hole.....
 Abandoned.....

Date

MAR 13 1929

CHAS. L. SHERWOOD

.....192..... Scout

