


Map No. KANSAS Sec. 12 Twp. 31 R. 8
 Well No. 2-Schrader Farm
Mann et al Company

1070 Ft. from N. Line
 _____ Ft. from S. Line
250 Ft. from E. Line
~~256~~ Ft. from W. Line

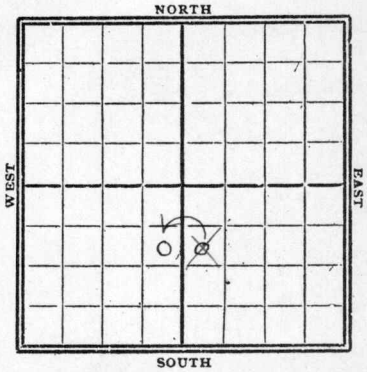

1928

Date	REPORT
12/19	Rig up.
12/26	
1929	
1/2	log 400'
1/9	log 600'
1/16	drlg 900'
1/23	" 1180'
1/30	SD. 1480'
2/6	sand 1508-65' SD. 1630'
2/13	
2/20	T.D. 2310' UR 6"-2200'
2/27	ing 6"-2310'
3/6	
3/13	Top Wilcox 2618' T.D. 2623'-HFW Plugging back to 1565'
	3/20 - sand 1508-65' Top Wilcox 2623' T.D. 2623'-HFW P.B. to 1565' 3 M gas

Elk

Map No. KANSAS Sec. 17 Twp. 31 R. 8

Well No. 2 *Schrader*

Mann et al Company

Contractor

FIRST REPORTS

SECTION PLAT

1070 Ft. from N. Line

..... Ft. from S. Line

..... Ft. from E. Line

250 Ft. from W. Line

		o	

Location.....

Rig up..... *Rigging up*

Drilling and Remarks:

RECORD

Cased.....in.,ft.

Sand.....

Gas.....

Oil.....

Total Depth.....

PRODUCTION

1st 24 hrs. Nat.....

1st 24 hrs. after shot.....

Gas.....Cu. Ft.

Dry Hole.....

Abandoned.....

Date

DEC 19 1928

CHAS. L. SHERWOOD

192

Scout

3 *Elk*
Map No. **KANSAS** Sec. *12* Twp. *31* R. *8*

Well No. *2 Schrader*
Mann et al Company

Contractor

CORRECTION


1070 Ft. from N. Line

Ft. from S. Line

750 Ft. from E. Line

Ft. from W. Line

SECTION PLAT

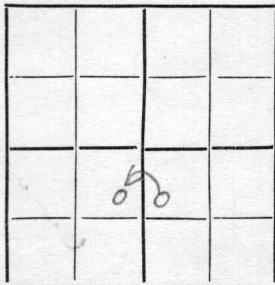

Location.....

Rig up.....

Drilling and Remarks:

*chg location
to above*

RECORD

Cased.....in.,ft.

Sand.....

Gas.....

Oil.....

Total Depth.....

PRODUCTION

1st 24 hrs. Nat.....

1st 24 hrs. after shot.....

Gas.....Cu. Ft.

Dry Hole.....

Abandoned.....

Date

MAR 13 1929

CHAS. L. SHERWOOD

.....192..... Scout

Map No. 3 **KANSAS** Sec. 12 Twp. 31 R. 8

Well No. 2 *Schrader*

Mann et al Company

Contractor

COMPLETE

SECTION PLAT

1070 Ft. from N. Line

..... Ft. from S. Line

750 Ft. from E. Line

..... Ft. from W. Line

Location.....

Rig up.....

Drilling and Remarks:

top Wilcox 7618'
AFW 7673'

PB to 1565'

Gas Well

RECORD

Cased..... in., ft.

Sand 1508-1565

Gas.....

Oil.....

Total Depth 7673

PRODUCTION

1st 24 hrs. Nat.....

1st 24 hrs. after shot.....

Gas 3 1/2 M Cu. Ft.

Dry Hole.....

Abandoned.....

Date

MAR 20 1929

CHAS. L. SHERWOOD

.....192..... Scout