


DX 78-1

Section 19 Township 31 Range 8E

Well No. 11 Ferguson

Company Rex & Morris

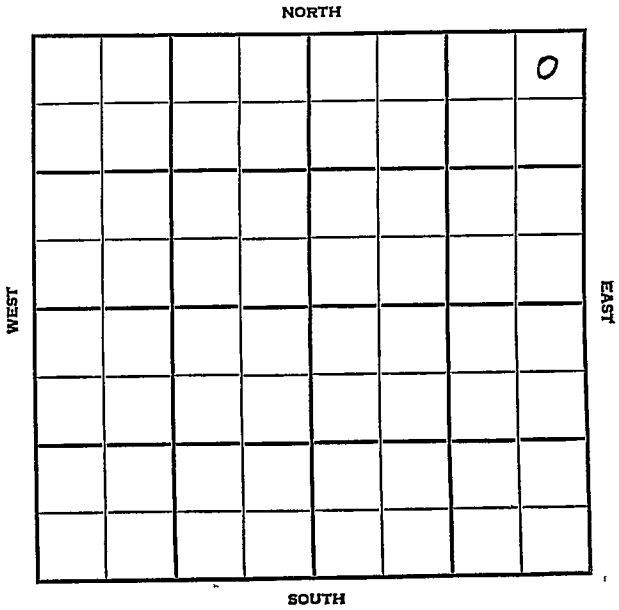

Cowleyn KANSAS

SEC.	TWP.	R.
19	31	8E
WELL NO.		
1 Ferguson		FARM
COMPANY		
Rex & Morris		
CONTRACTOR		


Wildcat

330 Ft. from N. Line

Ft. from S. Line

330 Ft. from E. Line

Ft. from W. Line

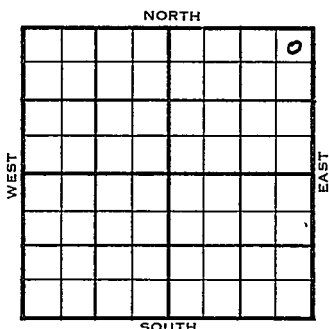

NE NE NE

	ELEVATION	REPORT
1954	1421'	

7/7 Setting surface
 9/15 spud 7-7-54
 D & A
 TD 2810'
 8" @987'
 Br. Lime 1279', Stal. 1318'; 2nd Stal. 1370' Lans 1629'; KC 1914', Layton 1942', B KC 2190', Cleve 2254', Pawnee 2307', Peru 2342', Ft. Scott 2392', Cherokee 2478', Cong 2738' Miss Chat. 2757' Miss Lime 2761' DST 1943'-50' opn 1 hr, rec 60' Mud, 120' Sw. 500#
 TD 2810'
 D & A

ABANDONED

County **Cowley** State **Kansas**Sec. **19** (Blk. Twp.) **31** (Sur. Rge.) **8E** Map No.Operator **Rex & Morris**Well No. **1** Farm **Ferguson**Elev. Location **NE NE NE**

330 Ft. From **N** Line **NE****330** Ft. From **E** Line Quarter1st. Report **JUL 7 1954**

Completion

Remarks

Spudding Date

Drlg. Data **Wildcat****setting surface**

County Cowley State Kansas

Sec. 19 (Blk. Twp.) 31 (Sur. Rge.) 8E Map No.

Operator Rex & Morris

Well No. 1 Farm Ferguson

Elev. 1421 Location NE NE NE

ABANDONED

330 Ft. From N Line NE c

330 Ft. From E Line Quarter

1st. Report

Completion **SEP 15 1954**

Remarks Wild cat

Spudding Date 7-7-54

Drig. Data D & A TD 2810

8" @ 987 Br. lime 1279 Stal. 1318

2nd Stal. 5370 Lans. 1629

KC 1914 Layton 1942 B KC 2190

Cleve. 2254 Pawnee 2307 Peru 2342

Ft. Scott 2392 Cherokee 2478

Cong. 2738 Miss. chat 2757

Miss. lime 2761 DST 1943-50

open 1 hr. Rec. 60' mud 120' sw

500# TD 2810

D & A

FABEN GILSTRAP