

Map No. **KANSAS** Sec. 27 Twp. 27 R. 8

Well No. 7 Keidy Farm
Booth & Fournak Company

NORTH

WEST

EAST

SOUTH

Location _____

Drilling Remarks

Rig Up _____

Drilling Remarks

RECORD

Cased _____ in. _____ ft.

Sand _____

Gas _____

Oil _____

Total Depth_____

PRODUCTION

1st 24 hrs. Nat. _____

1st 24 hrs. after shot_____

Gas_____cu. ft._____

Dry Hole_____


Abandoned _____

Cawley
Map No. KANSAS Sec. 31 Twp. 31 R. 8EWell No. 1- Ruddy Farm
Roth & Fournet Company250 Ft. from N. Line

_____ Ft. from S. Line

250 Ft. from E. Line

_____ Ft. from W. Line

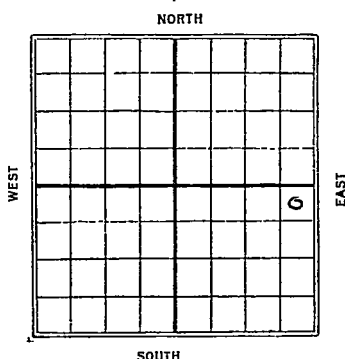

1929

Date

REPORT

10/9	Machine
10/16	Ran up
10/23	Spdy.
10/30	Drly 500'
11/6	" 825'
11/13	" 1200'
11/20	SD 1575' for 8"
11/27	Drly 1621'
12/4	Top sand 1926
12/11	set 6"-1931'
	Oil 1948-78
	Best pay 1978' T.D.
	1000' bill in 12 hrs.
12/23	Oil 1948-2004'
	pump 80 bbl 24 hrs.
12/30	
1930	
1/8	sand 1926-85'
	T.D. 2004'
	Oil 1948-78'
	Mky 100 bbl oil
	Comp.

Map No. KANSAS Sec. 31 Twp. 31 R. 8^E
 Well No. 1 Reidy

Roth & Faurat Company

Contractor

SECTION PLAT

FIRST REPORTS

250 Ft. from N. Line

_____ Ft. from S. Line

250 Ft. from E. Line

_____ Ft. from W. Line

			0

Location _____

Rig up Machino.

Drilling and Remarks:

RECORD

Cased _____ in., _____ ft.

Sand _____

Gas _____

Oil _____

Total Depth _____

PRODUCTION

1st 24 hrs. Nat. _____

1st 24 hrs. after shot _____

Gas _____ Cu. Ft.

Dry Hole _____

Abandoned _____

Date

OCT 9 1929

CHAS. L. SHERWOOD

19

Scout

Cowley

 Map No. **KANSAS** Sec. **31** Twp. **31** R. **8**
 Well No. **1** *Reidy*
Roth & Jaurat Company

Contractor

COMPLETE

750

Ft. from N. Line

Ft. from S. Line

750

Ft. from E. Line

Ft. from W. Line

SECTION PLAT

			0

Location

Rig up

Drilling and Remarks:

20 1948-1978

100 Bls.

RECORD

Cased _____ in., _____ ft.

Sand **1976-1985**

Gas _____

Oil _____

Total Depth **7004**

PRODUCTION

1st 24 hrs. Nat. _____

1st 24 hrs. after shot _____

Gas _____ Cu. Ft.

Dry Hole _____

Abandoned _____

Date

JAN 8 1930

192

CHAS. L. SHERWOOD

Scout