


Map No. KANSAS Sec. 1 Twp. 31 R. 9^E
Well No. 1- Schul Farm
Union Gas et al Company

NORTH

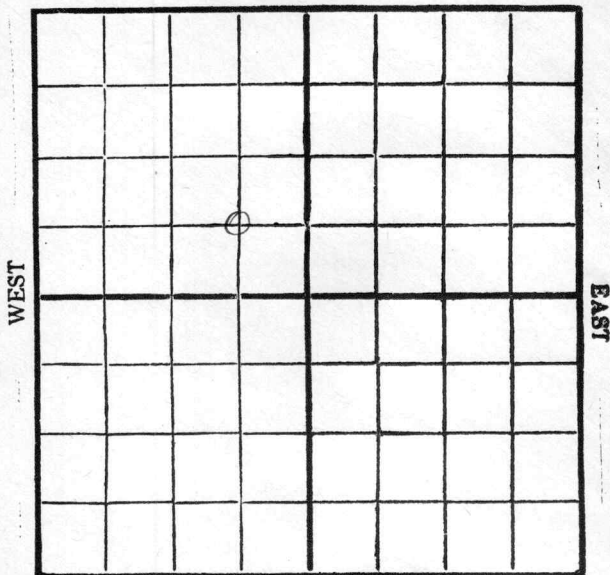

SOUTH

Location _____

Drilling Remarks _____

Rig Up _____

Drilling Remarks _____

RECORD

Cased _____ in. _____ ft.

Sand _____

Gas _____

Oil _____

Total Depth _____

PRODUCTION

1st 24 hrs. Nat. _____

1st 24 hrs. after shot _____

Gas _____ cu. ft.

Dry Hole _____


Abandoned _____

Elk

Map No. KANSAS Sec. 1 Twp. 31 R. 9^E

Well No. 1 - Schul Farm
Union Gas et al Company

_____ Ft. from N. Line
660 Ft. from S. Line
660 Ft. from E. Line
_____ Ft. from W. Line

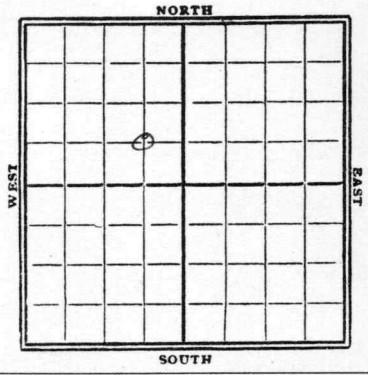

1929

Date	REPORT
7/17	Machine
7/24	Spdg.
7/31	Only 415'
8/17	" 675'
8/14	—
8/21	—
8/28	dry sand 1553-95 shut down
9/4	—
9/11	—
9/18	sand 1553-95' dry T.D. 1595' Dry & Abandoned

Map No. KANSAS Sec. 1 Twp. 31 R. 9^E

Well No. 1 Schul

Union Gas Co Company

Contractor

FIRST REPORTS

 Ft. from N. Line

660 Ft. from S. Line

660 Ft. from E. Line

 Ft. from W. Line

SECTION PLAT

	0		

Location

Rig up Machine

Drilling and Remarks:

RECORD

Cased in., ft.

Sand

Gas

Oil

Total Depth

PRODUCTION

1st 24 hrs. Nat.

1st 24 hrs. after shot

Gas Cu. Ft.

Dry Hole

Abandoned

Date

JUL 17 1929

19

CHAS. L. SHERWOOD

Scout

Elk

Map No. KANSAS Sec. 1 Twp. 31 R. 9

Well No. 1 Schul

Union Gas & Oil Company

Contractor

COMPLETE

SECTION PLAT

..... Ft. from N. Line

660 Ft. from S. Line

660 Ft. from E. Line

..... Ft. from W. Line

ABANDONED

Location.....

Rig up.....

Drilling and Remarks:

RECORD

Cased..... in., ft.

Sand 1553-1595 Dry

Gas.....

Oil.....

Total Depth 1595

PRODUCTION

1st 24 hrs. Nat.....

1st 24 hrs. after shot.....

Gas..... Cu. Ft.

Dry Hole

Abandoned

Date

SEP 18 1929

CHAS. L. SHERWOOD

192

Scout