


Map No. _____ Sec. 2 Twp. 31 R. 9Well No. 1 Schull Farm
Hoyt et al Company

NORTH

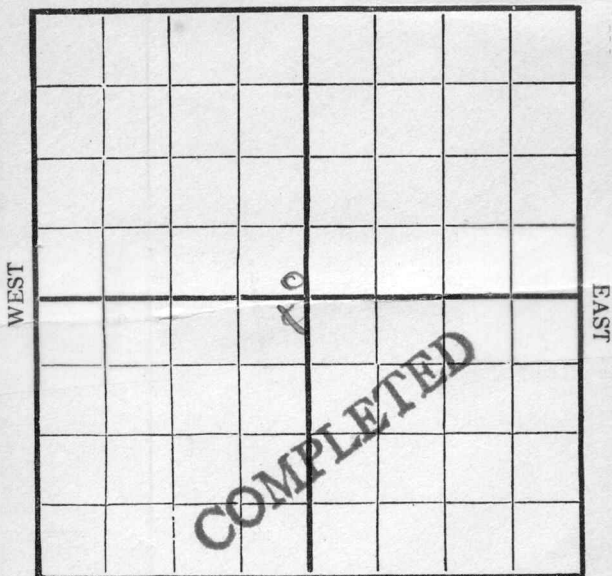

SOUTH

Location _____

Rig Up 5/20

Drilling Remarks:

Drilling Remarks:

9/30 - 600 - S.D.
10/7 - 600 - S.D.
10/28 - 800
11/4 - 970
11/18 - 1030 - 11/25
12/2 - 1225
12/9 - 1350
12/23 - 1400 = 12/30

10/14 - 10/21 =

1/6 - 1/13 - 1/20 =

RECORD

PRODUCTION

Cased _____ in _____ Ft.

1st 24 hrs. Nat. _____

Sand _____

1st 24 hrs. after shot _____

Gas _____

Gas _____ Cu. Ft.

Oil _____

Dry Hole _____

Total Depth _____


Abandoned _____

Map No. _____ Sec. 2 Twp. 31 R. 9Well No. 1 Schull FarmHoyt et al Company

NORTH

WEST

EAST

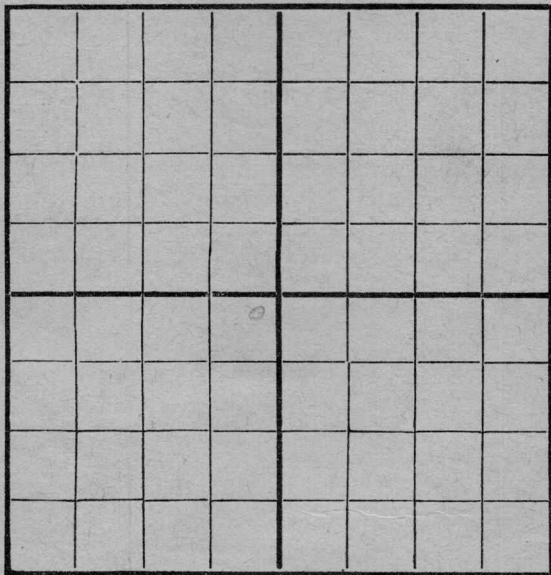

SOUTH

Location _____

Rig Up ☒ _____

Drilling and remarks _____

RECORD

Cased _____ in. _____ Ft.

Sand _____

Gas _____

Oil _____

Total Depth _____

PRODUCTION

1st 24 hrs. Nat. _____

1st 24 hrs. after shot _____

Gas _____ Cu. Ft.

Dry Hole _____

Abandoned _____

Date

5-20, 1916 Schull Scout

Map No. _____ Sec. 2 Twp. 31 R. 9Well No. 1. Schuchman Farm _____Company Long Keaf

NORTH

WEST

EAST

SOUTH

Location _____

Rig Up _____

Drilling and remarks

100'

RECORD

Cased _____ in. _____ Ft.

Sand _____

Gas _____

Oil _____

Total Depth _____

PRODUCTION

1st 24 hrs. Nat. _____

1st 24 hrs. after shot _____

Gas _____ Cu. Ft.

Dry Hole _____

Abandoned _____


Date

6/9, 1915 LLP Scout

Map No. _____ Sec. 2 Twp. 31 R. 9
 Well No. 1 Schull Farm _____
Loyt & Mc Ginnis Company

NORTH

WEST

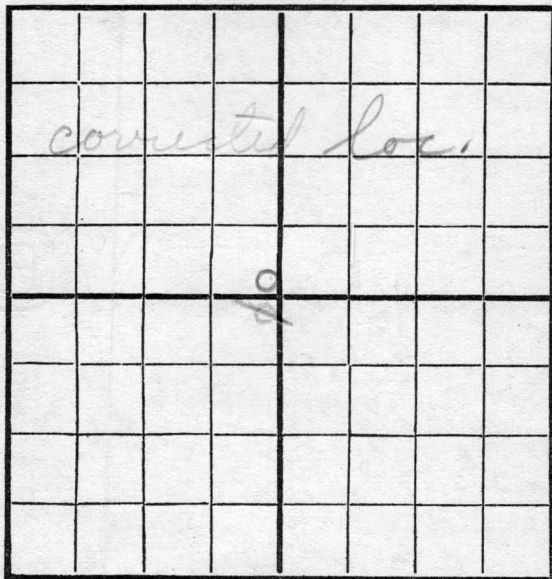

EAST

SOUTH

Location _____

Rig Up _____

Drilling and remarks

S.D. 2600

RECORD

Cased _____ in. _____ Ft.

Sand _____

Gas _____

Oil _____

Total Depth _____

PRODUCTION

1st 24 hrs. Nat. _____

1st 24 hrs. after shot _____

Gas _____ Cu. Ft.

Dry Hole _____


Abandoned _____

Date

7/22, 1916 L. H. Farnsworth Scout

Map No. _____ Sec. 2 Twp. 31 R. 9
 Well No. 1 Schull Farm _____
Hoyt et al. Company _____

NORTH

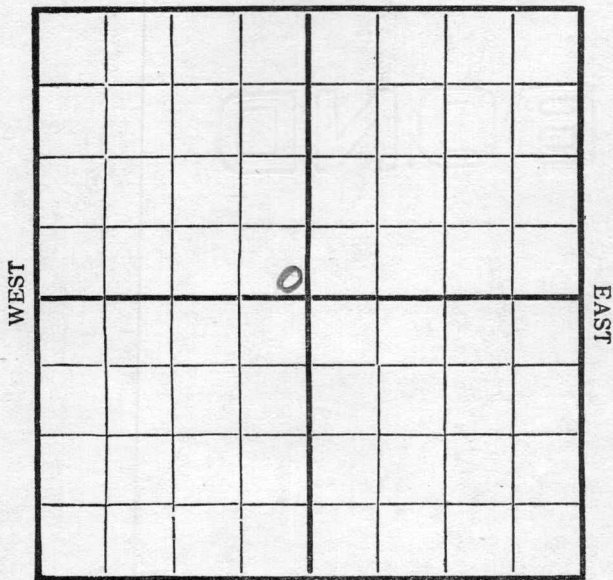

SOUTH

Location _____
 Rig Up _____
 Drilling and remarks _____

S.D. 600.

RECORD

Cased _____ in. _____ Ft.
 Sand _____
 Gas _____
 Oil _____
 Total Depth _____

PRODUCTION


1st 24 hrs. Nat. _____
 First 24 h.s. after shot _____
 Gas _____ Cu. Ft.
 Dry Hole _____
 Abandoned _____

Date

7/30, 1916 H. Farnsworth Scout

Map No. _____ Sec. 2 Twp. 31 R. 9
 Well No. 1 Schull Farm _____
Hoyt et al. Company _____

NORTH

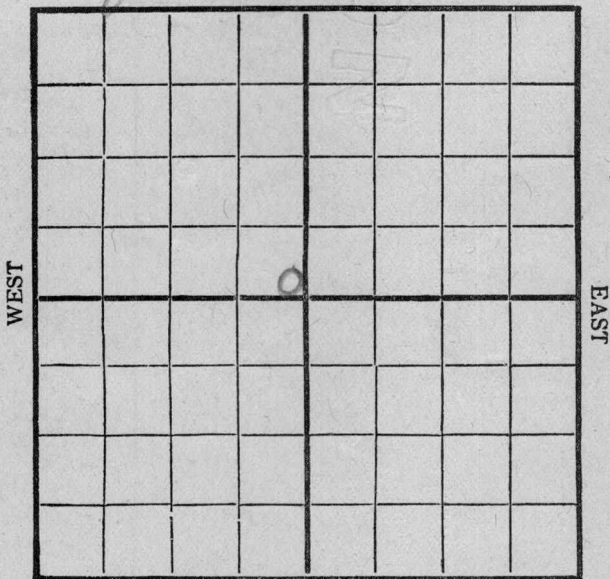

SOUTH

Location _____

Rig Up _____

Drilling and remarks

600 S.D.

RECORD

Cased _____ in. _____ Ft.

Sand _____

Gas _____

Oil _____

Total Depth _____

PRODUCTION

1st 24 hrs. Nat. _____

First 24 h.s. after shot _____

Gas _____ Cu. Ft.

Dry Hole _____

Abandoned _____

Date

8/12, 1916 H. Tarns Scout

Map No. _____ Sec. 2 Twp. 31 R. 9Well No. 1 Schull FarmHoyt et al. Company

NORTH

WEST

EAST

SOUTH

Location _____

Rig Up _____

Drilling and remarks

S.D. 600

RECORD

Cased _____ in. _____ Ft.

Sand _____

Gas _____

Oil _____

Total Depth _____

PRODUCTION

1st 24 hrs. Nat. _____

1st 24 hrs. after shot _____

Gas _____ Cu. Ft.

Dry Hole _____

Abandoned _____

Date

8/19, 191 6 H. Farns Scout

Map No. _____ Sec. 2 Twp. 31 R. 9
 Well No. 1 Schull Farm
Hoyt et al Company

NORTH

WEST

EAST

SOUTH

Location _____

Rig Up _____

Drilling and remarks

S.D. 600

RECORD

Cased _____ in. _____ Ft.

Sand _____

Gas _____

Oil _____

Total Depth _____

PRODUCTION

1st 24 hrs. Nat. _____

1st 24 hrs. after shot _____

Gas _____ Cu. Ft.

Dry Hole _____

Abandoned _____

Date


8/26191 6

Scout

L. H. West

Map No. _____ Sec. 2 Twp. 31 R. 9
 Well No. 1 Schull Farm
Hoyt et al Company

NORTH

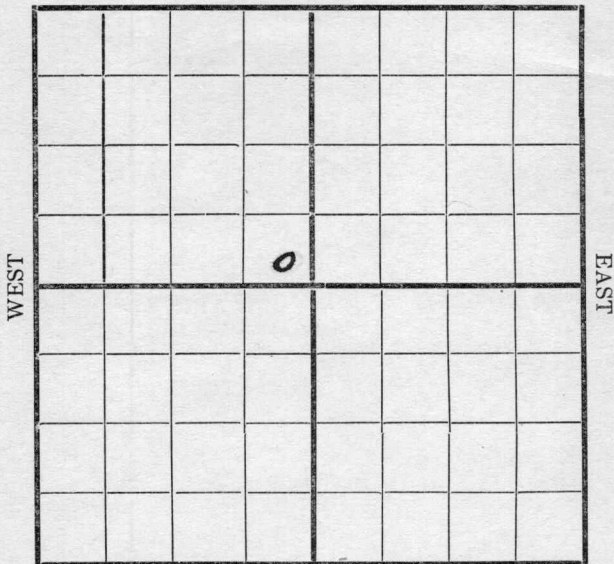

SOUTH

Location _____

Rig Up _____

Drilling and remarks

S.D. 600

RECORD

Cased _____ in. _____ Ft.

Sand _____

Gas _____

Oil _____

Total Depth _____

PRODUCTION

1st 24 hrs. Nat. _____

1st 24 hrs. after shot _____

Gas _____ Cu. Ft.

Dry Hole _____

Abandoned _____

Date

9/2


1916

E. Hewitt

Scout

Map No. _____ Sec. 2 Twp. 31 R. 9
 Well No. 1 Schull Farm
Hoyt et al Company

NORTH

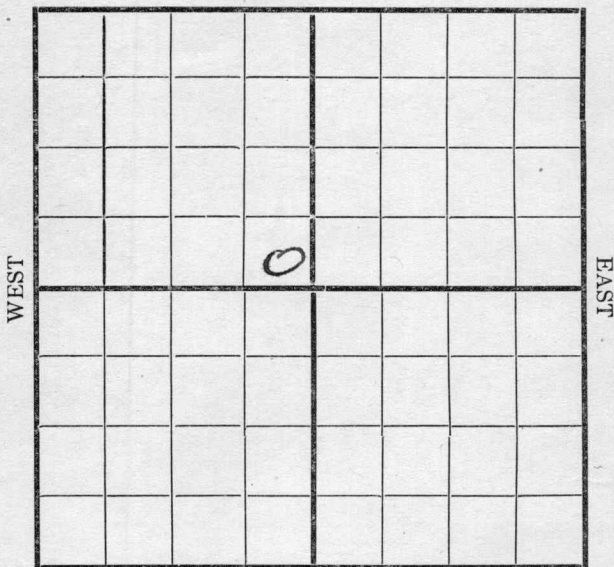

SOUTH

Location _____
 Rig Up _____
 Drilling and remarks

S.D. 600
for water

RECORD

Cased _____ in. _____ Ft.
 Sand _____
 Gas _____
 Oil _____
 Total Depth _____

PRODUCTION

1st 24 hrs. Nat. _____
 1st 24 hrs. after shot _____
 Gas _____ Cu. Ft.
 Dry Hole _____
 Abandoned _____

Date


_____, 191____. _____ Scout

Map No. _____ Sec. 2 Twp. 31 R. 9

Well No. 1 Schull Farm
Hoyt et al Company

NORTH

WEST

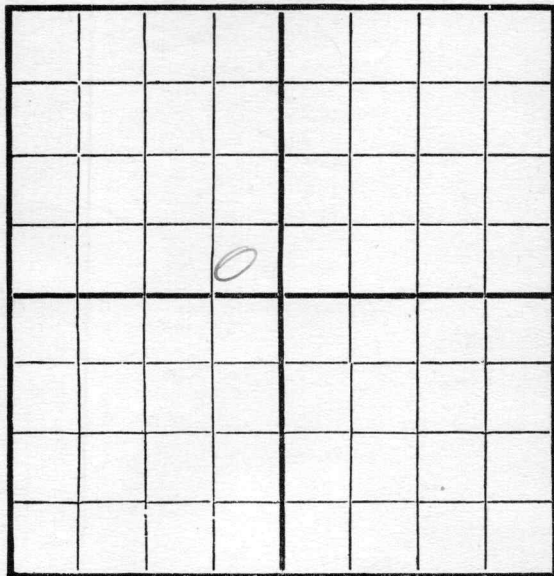

EAST

SOUTH

Location _____

Rig Up _____

Drilling and remarks

52.600

RECORD

Cased _____ in. _____ Ft.

Sand _____

Gas _____

Oil _____

Total Depth _____

PRODUCTION

1st 24 hrs. Nat. _____

First 24 hrs. after shot _____

Gas _____ Cu. Ft.

Dry Hole _____

Abandoned _____

Date

9/16, 1916

Excess


Scout

Map No. 611 Sec. 2 Twp. 31 R. 9

Well No. 1 Schuel Farm

Hoyt et al Company

NORTH

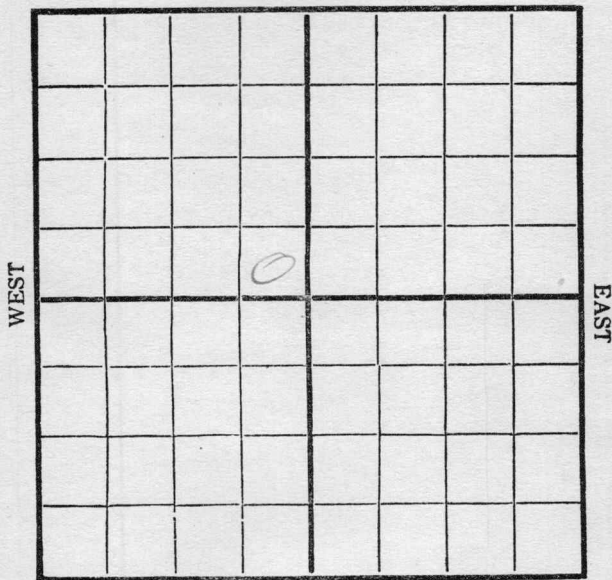

SOUTH

Location.....

Rig Up.....

Drilling and remarks

SD 600

RECORD

Cased.....in.Ft.

Sand.....

Gas.....

Oil.....

Total Depth.....

PRODUCTION

1st 24 hrs. Nat.....

First 24 hrs. after shot.....

Gas.....Cu. Ft.

Dry Hole.....

Abandoned.....

Date


9/23, 1916

E. Hevest

Scout

Map No. _____ Sec. 2 Twp. 31 R. 9
Well No. 1 Schull Farm
Hoyt et al Company

NORTH

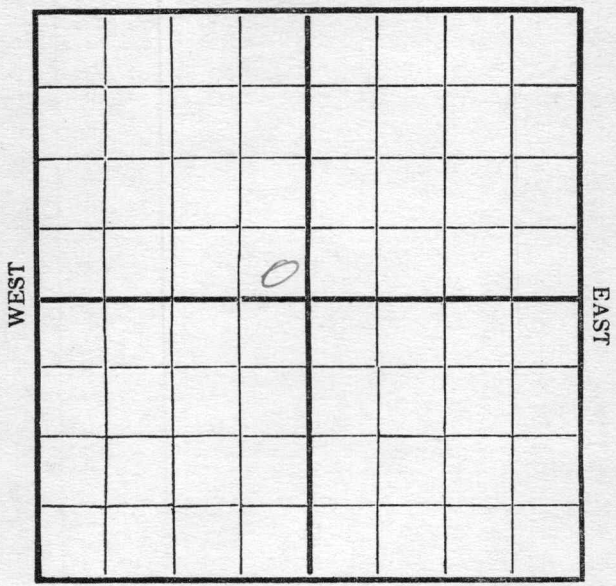

SOUTH

Location _____
Rig Up _____
Drilling and remarks
SD - 600

RECORD

Cased _____ in. _____ Ft.
Sand _____
Gas _____
Oil _____
Total Depth _____


PRODUCTION

1st 24 hrs. Nat. _____
1st 24 hrs. after shot _____
Gas _____ Cu. Ft.
Dry Hole _____
Abandoned _____

Date 9/30, 1916 E. Hoyt Scout

Eek
Map No. _____ Sec. *2* Twp. *31* R. *9*
Well No. *1 Schull* Farm
Hayt et al Company

NORTH

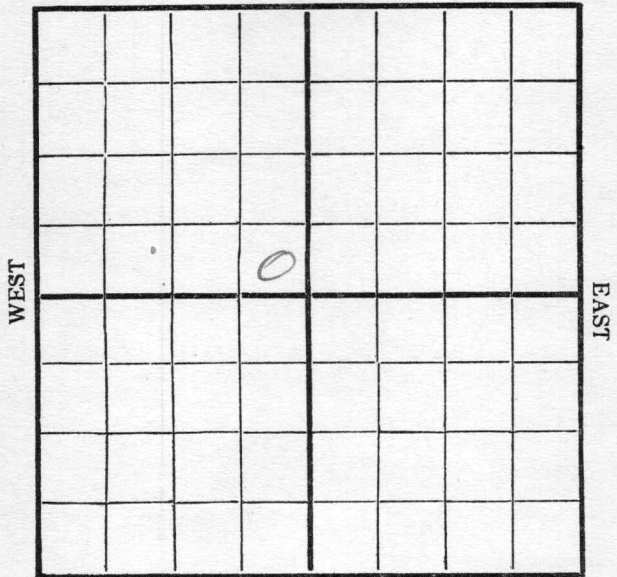

SOUTH

Location _____
Rig Up _____
Drilling and remarks
SD-600

RECORD

Cased _____ in. _____ Ft.
Sand _____
Gas _____
Oil _____
Total Depth _____

PRODUCTION


1st 24 hrs. Nat. _____
1st 24 hrs. after shot _____
Gas _____ Cu. Ft.
Dry Hole _____
Abandoned _____

Date *10/7*, 191*6*. *Green* Scout

Map No. _____ Sec. 4 Twp. 31 R. 9
 Well No. 1 Schuel Farm
Hoyt et al Company

NORTH

WEST

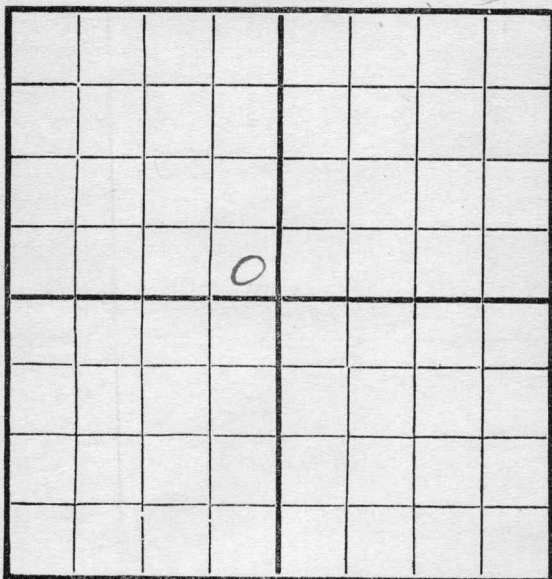

EAST

SOUTH

Location _____
 Rig Up _____
 Drilling and remarks _____

SD-600

RECORD

Cased _____ in. _____ Ft.
 Sand _____
 Gas _____
 Oil _____
 Total Depth _____

PRODUCTION

1st 24 hrs. Nat. _____
 First 24 hrs. after shot _____
 Gas _____ Cu. Ft.
 Dry Hole _____
 Abandoned _____

Date


10/14, 1916

Exxon

Scout

Map No. **ELK** Sec. **2** Twp. **31** R. **2**
 Well No. **1** **Schull** Farm
Hoyt et al Company

NORTH

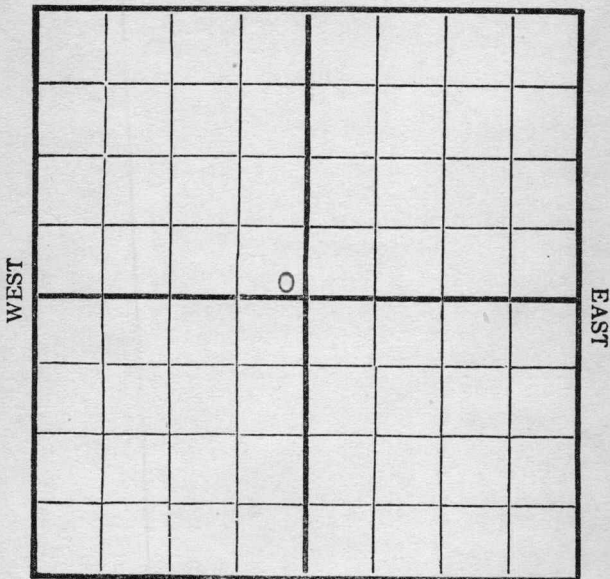

SOUTH

Location

Rig Up

Drilling and remarks

SD 600

RECORD

Cased in. Ft.

Sand

Gas

Oil

Total Depth

PRODUCTION

1st 24 hrs. Nat.

First 24 hrs. after shot

Gas Cu. Ft.

Dry Hole

Abandoned

Date

OCT 21 1916

E. H. WEST


Scout

ELK

Map No. _____ Sec. 2 Twp. 31 R. 9Well No. 1 Schull Farm __________ Hoyt et al Company

NORTH

WEST

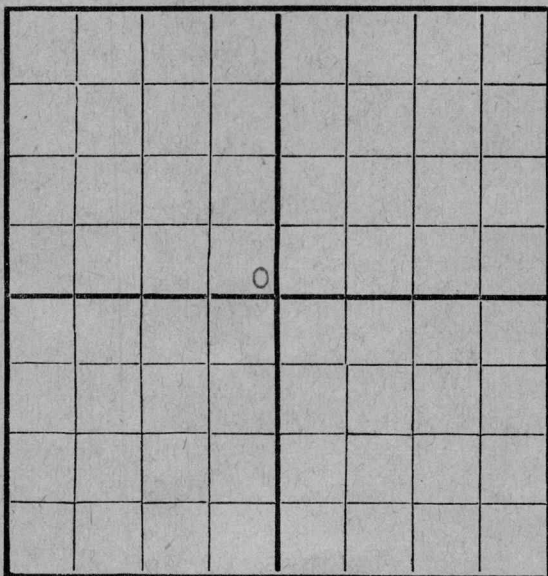

EAST

SOUTH

Location _____

Rig Up _____

Drilling and remarks

800

RECORD

Cased _____ in. _____ Ft.

Sand _____

Gas _____

Oil _____

Total Depth _____

PRODUCTION

1st 24 hrs. Nat. _____

1st 24 hrs. after shot _____

Gas _____ Cu. Ft.

Dry Hole _____

Abandoned _____

Date

OCT 28 1916

191

E. H. WEST

Scout


Map No. _____ Sec. 2 Twp. 31 R. 9

Well No. 1 Schull Farm _____

_____ Hoyt et al Company

NORTH

WEST

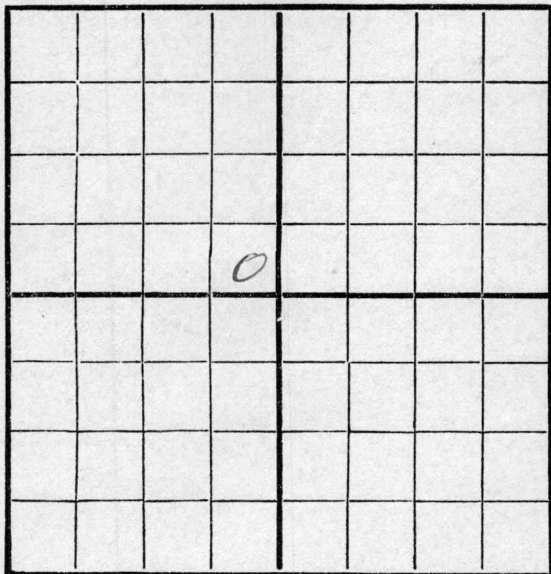

EAST

SOUTH

Location _____

Rig Up _____

Drilling and remarks

✓
970

RECORD

Cased _____ in. _____ Ft.

Sand _____

Gas _____

Oil _____

Total Depth _____

PRODUCTION

1st 24 hrs. Nat. _____

1st 24 hrs. after shot _____

Gas _____ Cu. Ft.

Dry Hole _____

Abandoned _____

Date

11/4, 191 6

E. H. WEST Scout


ELK

Map No. _____ Sec. 2 Twp. 31 R 9

Well No. 1 Schull Farm

Hoyt et al Company

NORTH

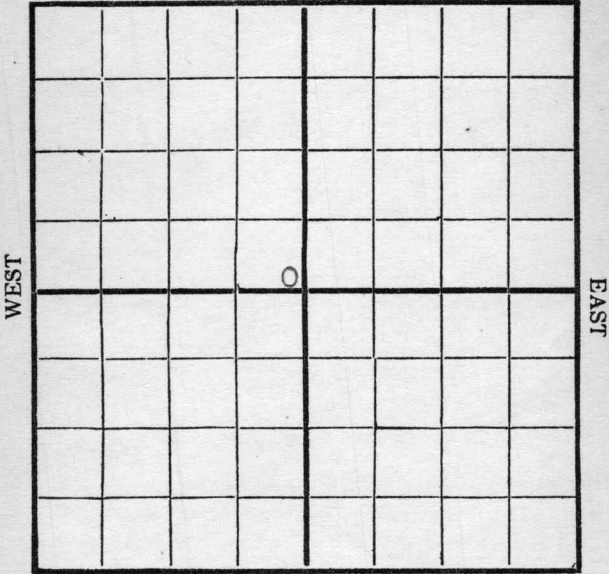

SOUTH

Location _____
Rig Up _____
Drilling and remarks
S.D.-1030

RECORD

Cased _____ in. _____ Ft.
Sand _____
Gas _____
Oil _____
Total Depth _____

PRODUCTION

1st 24 hrs. Nat. _____
1st 24 hrs. after shot _____
Gas _____ Cu. Ft.
Dry Hole _____
Abandoned _____

Date

NOV 11 1916


E. H. WEST

Scout

ELK

Map No. _____ Sec. 2 Twp. 31 R. 9Well No. 1 Schull _____ Farm_____ Hoyt et al _____ Company

NORTH

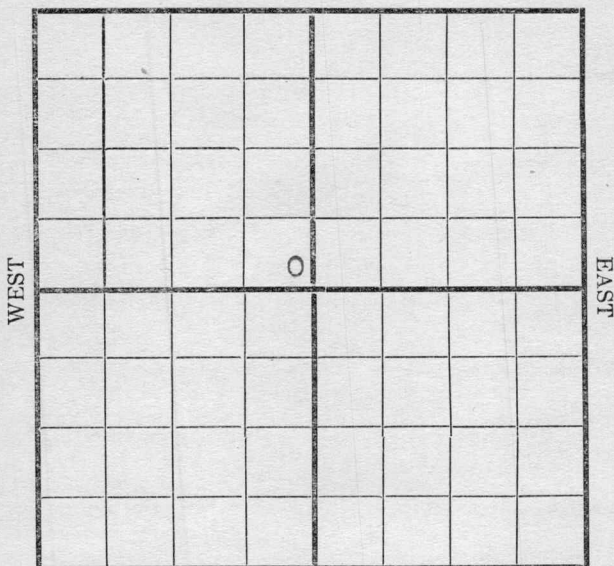

SOUTH

Location _____

Rig Up _____

Drilling and remarks

S.D.-1030 water

RECORD

Cased _____ in. _____ Ft.

Sand _____

Gas _____

Oil _____

Total Depth _____

PRODUCTION

1st 24 hrs. Nat. _____

1st 24 hrs. after shot _____

Gas _____ Cu. Ft.

Dry Hole _____

Abandoned _____

Date

NOV 18 1916


191

E. H. WEST Scout

ELK

Map No. _____ Sec. 2 Twp. 31 R. 9Well No. 1 Schull _____ Farm_____ Hoyt et al _____ Company

NORTH

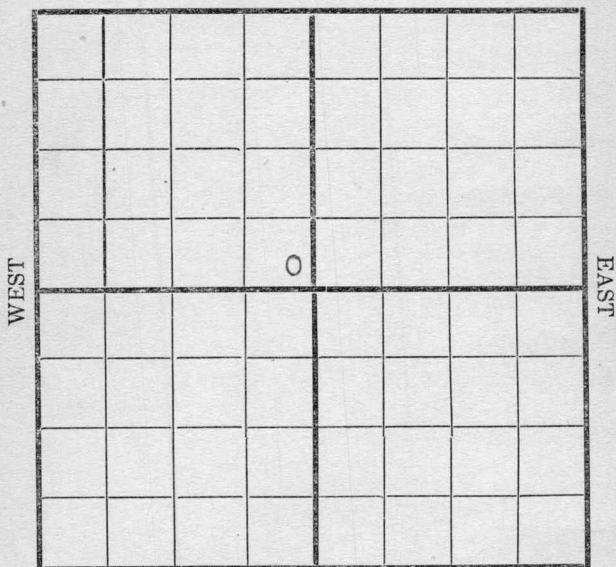

SOUTH

Location _____

Rig Up _____

Drilling and remarks

SD-1030

RECORD

Cased _____ in. _____ Ft.

Sand _____

Gas _____

Oil _____

Total Depth _____

PRODUCTION

1st 24 hrs. Nat. _____

1st 24 hrs. after shot _____

Gas _____ Cu. Ft.

Dry Hole _____

Abandoned _____

Date

NOV 25 1916

, 191

E. H. WEST


Scout

ELK

Map No. _____ Sec. 2 Twp. 31 R. 9Well No. 1 Schull Farm _____

_____ Hoyt et al _____ Company

NORTH

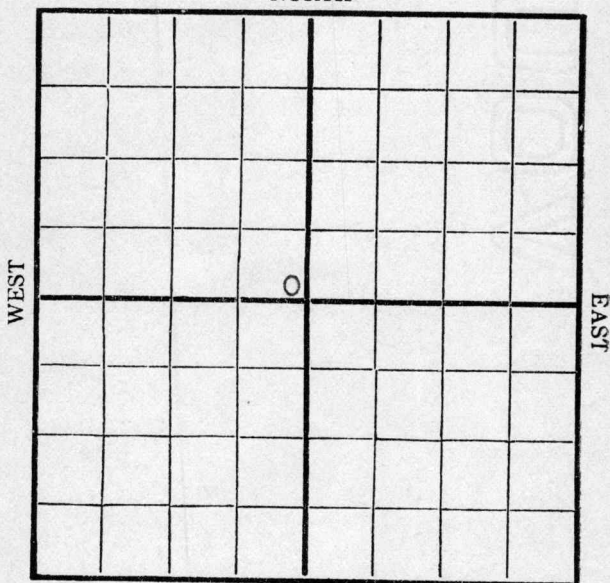

SOUTH

Location _____

Rig Up _____

Drilling and remarks _____

1225

*running daylight
only*

RECORD

Cased _____ in. _____ Ft.

Sand _____

Gas _____

Oil _____

Total Depth _____

PRODUCTION

1st 24 hrs. Nat. _____

1st 24 hrs. after shot _____

Gas _____ Cu. Ft.

Dry Hole _____

Abandoned _____

Date

DEC - 2 1916

191

4. WEST


Scout

ELK

Map No. _____ Sec. 22 Twp. 31 R. 9Well No. 1 Schull Farm _____Hay F et al Company _____

NORTH

WEST

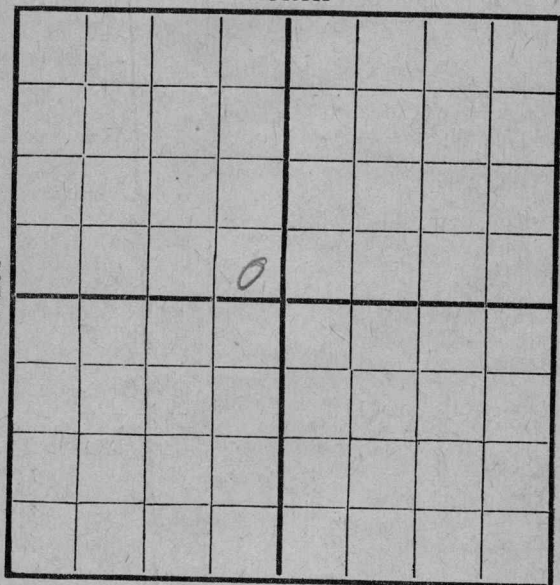

EAST

SOUTH

Location _____

Rig Up _____

Drilling and remarks _____

RECORD

Cased _____ in. _____ Ft.

Sand _____

Gas _____

Oil _____

Total Depth _____

PRODUCTION

1st 24 hrs. Nat. _____

1st 24 hrs. after shot _____

Gas _____ Cu. Ft.

Dry Hole _____

Abandoned _____

Date

DEC -9 1916

191

E. H. WEST

Scout


ELK

Map No. _____ Sec. 2 Twp. 31 R. 4Well No. 1 Schull Farm _____Hoyt et al Company

NORTH

WEST

EAST

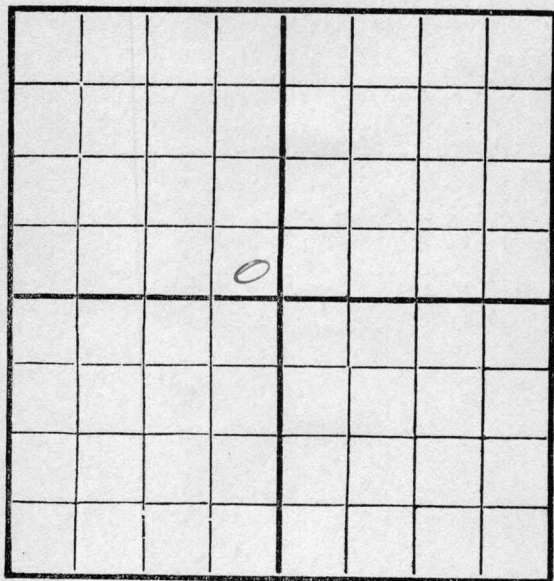

SOUTH

Location _____

Rig Up _____

Drilling and remarks

SD-1400

RECORD

Cased _____ in. _____ Ft.

Sand _____

Gas _____

Oil _____

Total Depth _____

PRODUCTION

1st 24 hrs. Nat. _____

1st 24 hrs. after shot _____

Gas _____ Cu. Ft.

Dry Hole _____

Abandoned _____

Date DEC 16 1916

E. H. WEST

, 191 _____

Scout

ELK


Map No. _____ Sec. 2 Twp. 31 R. 9

Well No. 1 Schull Farm

Hoyt et al Company

NORTH

WEST

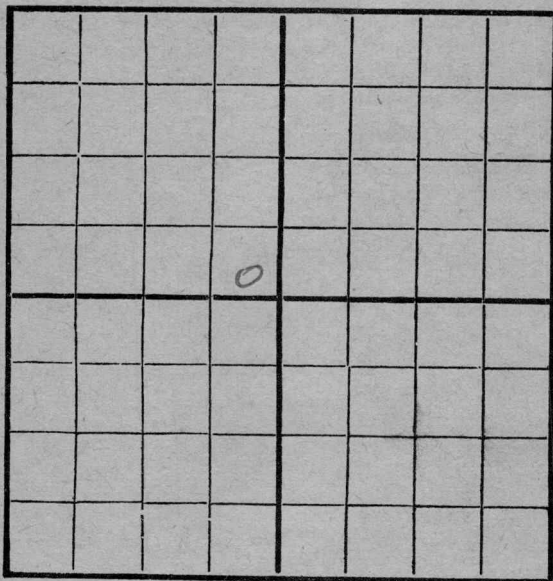

EAST

SOUTH

Location _____

Rig Up _____

Drilling and remarks

SD-1400

RECORD

Cased _____ in. _____ Ft.

Sand _____

Gas _____

Oil _____

Total Depth _____

PRODUCTION

1st 24 hrs. Nat. _____

1st 24 hrs. after shot _____

Gas _____ Cu. Ft.

Dry Hole _____

Abandoned _____

Date

DEC 23 1916


, 191

E. H. WEST

Scout

Map No. **ELK** Sec. **2** Twp. **31** R. **9**
 Well No. **1 Schull** Farm
Hoyt et al Company

NORTH

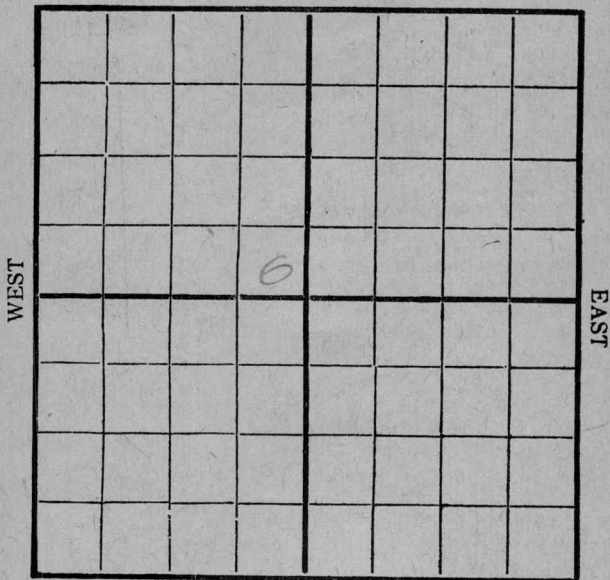

SOUTH

Location

Rig Up

Drilling and remarks

SD-1400

RECORD

Cased in. Ft.

Sand

Gas

Oil

Total Depth

PRODUCTION

1st 24 hrs. Nat.

1st 24 hrs. after shot

Gas Cu. Ft.

Dry Hole

Abandoned

Date

E. H. WEST

Scout


DEC 30 1916

191

ELK

Map No. _____ Sec. 2 Twp. 31 R. 9Well No. 1 Schull Farm _____Noyt et al Company

NORTH

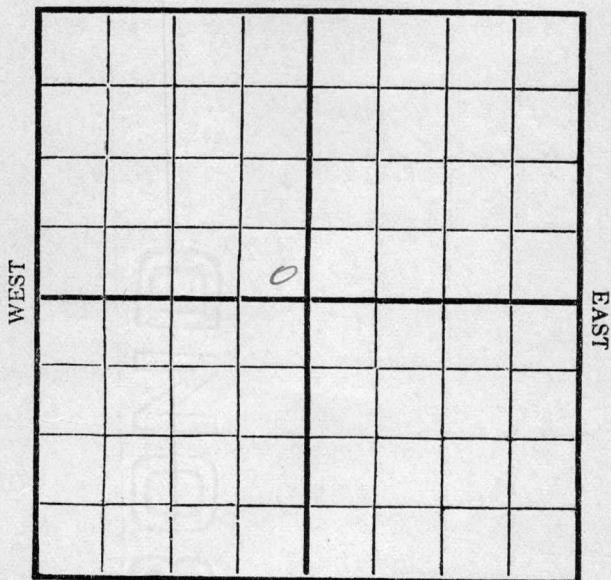

SOUTH

Location _____

Rig Up _____

Drilling and remarks

SD-1400

RECORD

Cased _____ in. _____ Ft.

Sand _____

Gas _____

Oil _____

Total Depth _____

PRODUCTION

1st 24 hrs. Nat. _____

1st 24 hrs. after shot _____

Gas _____ Cu. Ft.

Dry Hole _____

Abandoned _____

Date

JAN - 6 1917E. H. WEST Scout


ELK

Map No. _____ Sec. 2 Twp. 31 R. 9

Well No. 1 Schull Farm _____
Hoyt et al Company

NORTH

WEST

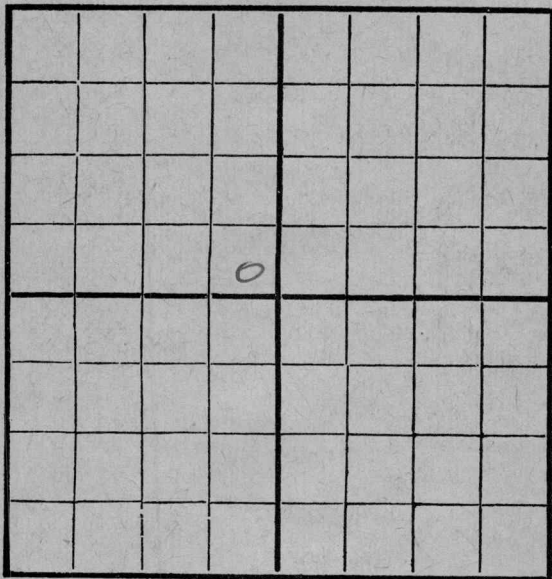

EAST

SOUTH

Location _____
 Rig Up _____
 Drilling and remarks

52-1400

RECORD

Cased _____ in. _____ Ft.
 Sand _____
 Gas _____
 Oil _____
 Total Depth _____

PRODUCTION

1st 24 hrs. Nat. _____
 1st 24 hrs. after shot _____
 Gas _____ Cu. Ft.
 Dry Hole _____
 Abandoned _____

Date

E. H. WEST


JAN 13 1917

Scout

ELK

Map No. _____ Sec. 2 Twp. 31 R. 9
 Well No. 1 Shull Farm _____
 _____ Hoyt et al Company

NORTH

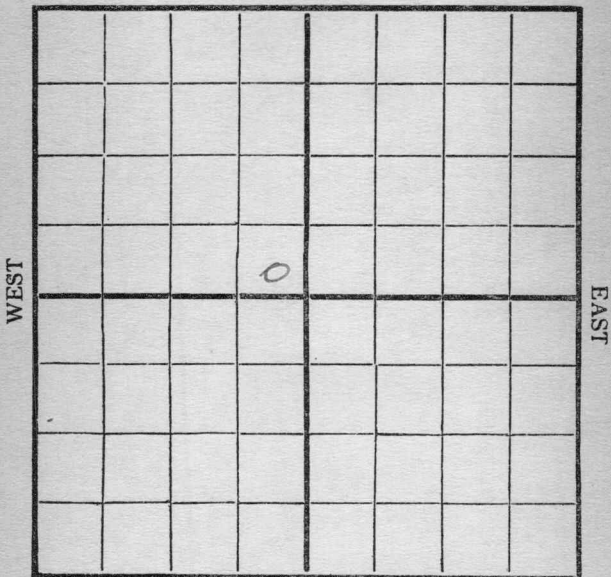

SOUTH

Location _____
 Rig Up _____
 Drilling and remarks

50-1400

RECORD

Cased _____ in. _____ Ft.
 Sand _____
 Gas _____
 Oil _____
 Total Depth _____

PRODUCTION

1st 24 hrs. Nat. _____
 1st 24 hrs. after shot _____
 Gas _____ Cu. Ft.
 Dry Hole _____
 Abandoned _____

Date JAN 20 1917


E. H. WEST

_____, 191____ Scout

ELK

Map No. _____ Sec. 2 Twp. 31 R. 9Well No. 1 Schull FarmLloyd et al Company

NORTH

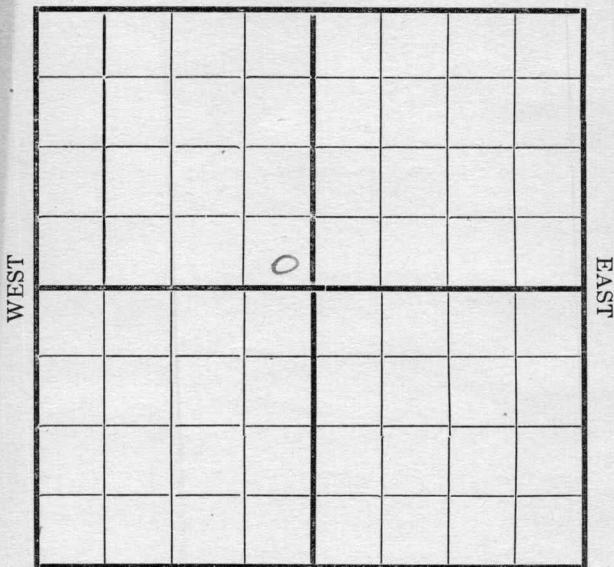

SOUTH

Location _____

Rig Up _____

Drilling and remarks

SD-1400

RECORD

Cased _____ in. _____ Ft.

Sand _____

Gas _____

Oil _____

Total Depth _____

PRODUCTION

1st 24 hrs. Nat. _____

1st 24 hrs. after shot _____

Gas _____ Cu. Ft.

Dry Hole _____

Abandoned _____

Date


JAN 27 1917

191

E. H. WEST Scout

Map No. Elk Sec. 2 Twp. 31 R. 9
 Well No. 1 Schull Farm
Hoyt et al Company

NORTH

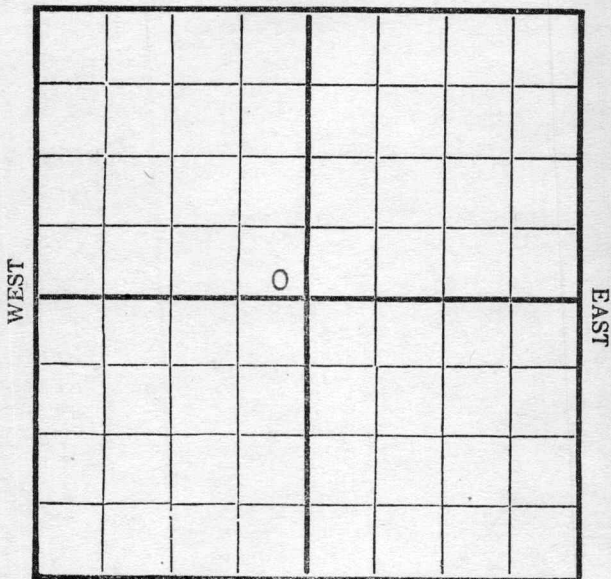

SOUTH

Location

Rig Up

Drilling and remarks

50-1400

RECORD

Cased in. Ft.

Sand

Gas

Oil

Total Depth

PRODUCTION

1st 24 hrs. Nat.

First 24 hrs. after shot

Gas Cu. Ft.

Dry Hole

Abandoned

Date

FEB 10 1917

, 191

E. H. WEST

Scout

Map No. _____ Sec. 2 Twp. 31 R. 9
 Well No. 1 Schull Farm
Hoyt et al Company

NORTH

WEST

EAST

SOUTH

Location _____
 Rig Up _____
 Drilling and remarks

S.D. 1400

RECORD

Cased _____ in. _____ Ft.
 Sand _____
 Gas _____
 Oil _____
 Total Depth _____

PRODUCTION

1st 24 hrs. Nat. _____
 1st 24 hrs. after shot _____
 Gas _____ Cu. Ft.
 Dry Hole _____
 Abandoned _____

Date


FEB 17, 1917

P. J. Brooker Scout

Map No: _____ Sec. 2 Twp. 31 R. 9

Well No. 1 Schull Farm

Hoyt et al. Company

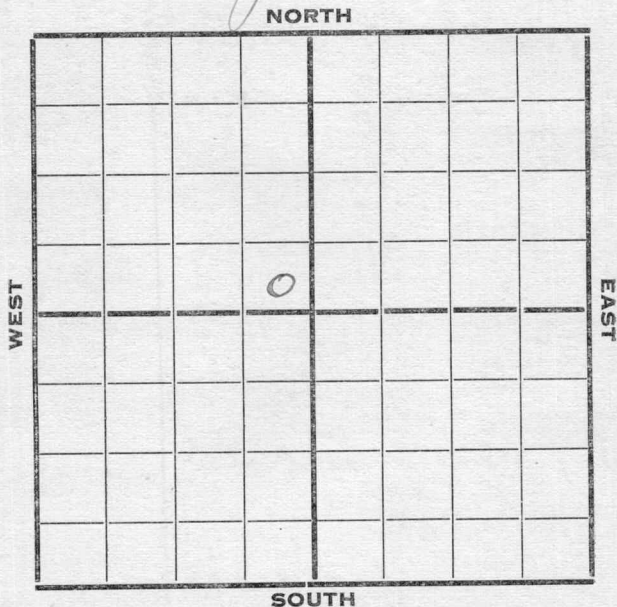

Location _____

Rig up _____

Drilling and Remarks:

S.D. 1400

RECORD

Cased _____ in. _____ Ft.

Sand _____

Gas _____

Oil _____

Total Depth _____

PRODUCTION

1st 24 hrs. Nat. _____

1st 24 hrs. after shot _____

Gas _____ Cu. Ft.

Dry Hole _____

Abandoned _____

Date

FEB 24 1917

191

C. J. Crocker Scout

Elk


Map No. _____ Sec. *2* Twp. *131* R. *9*

Well No. *1* *Schull* Farm _____

Hoyt et al Company _____

NORTH

WEST

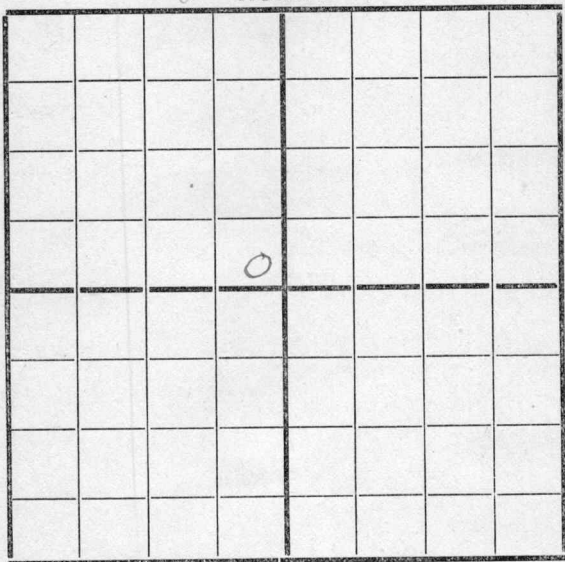

EAST

SOUTH

Location _____

Rig up _____

Drilling and Remarks:

S.S. 1400

RECORD

Cased _____ in. _____ Ft.

Sand _____

Gas _____

Oil _____

Total Depth _____

PRODUCTION

1st 24 hrs. Nat. _____

1st 24 hrs. after shot _____

Gas _____ Cu. Ft.

Dry Hole _____

Abandoned _____

Date


MAR 3 1917

_____, 191____,

C. J. Crocker Scout

Map No. _____ Sec. 2 Twp. 31 R. 9Well No. Schull Farm _____Hoyt et al Company

NORTH

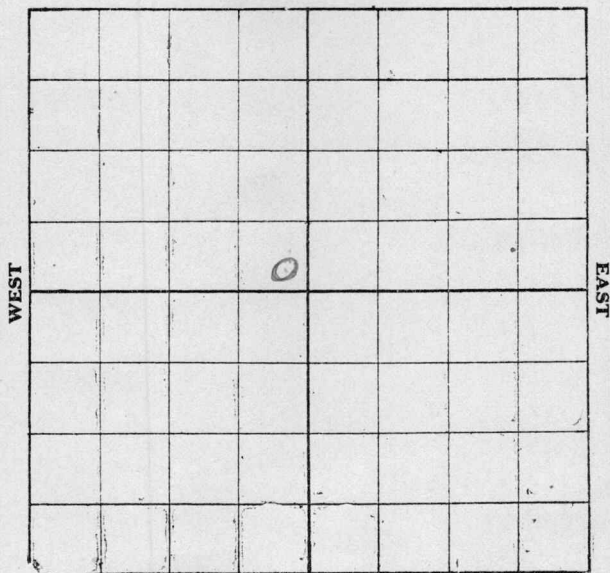

SOUTH

RECORD

Location _____

Rig up _____

Drilling and Remarks:

S.D. 1400'

Cased _____ in. _____ Ft.

Sand _____

Gas _____

Oil _____

Total Depth _____

PRODUCTION

1st 24 hrs. Nat. _____

1st 24 hrs. after shot _____

Gas _____ Cu. Ft.

Dry Hole _____

Abandoned _____

Date

3/10, 1917 L. J. Howker Scout

Map No. _____ Sec. 2 Twp. 31 R. 9Well No. 1 Schull FarmHoyt & al Company

NORTH

WEST

EAST

SOUTH

Location _____

Rig Up _____

Drilling and remarks

S.D. 1400

RECORD

Cased _____ in. _____ Ft.

Sand _____

Gas _____

Oil _____

Total Depth _____

PRODUCTION

1st 24 hrs. Nat. _____

1st 24 hrs. after shot _____

Gas _____ Cu. Ft.

Dry Hole _____

Abandoned _____

Date


MAR 17 1917

191

C. J. Crocker
Scout

Map No. _____ Sec. 2 Twp. 31 R. 9
 Well No. 1 Schull Farm
Hoyt et al Company

NORTH

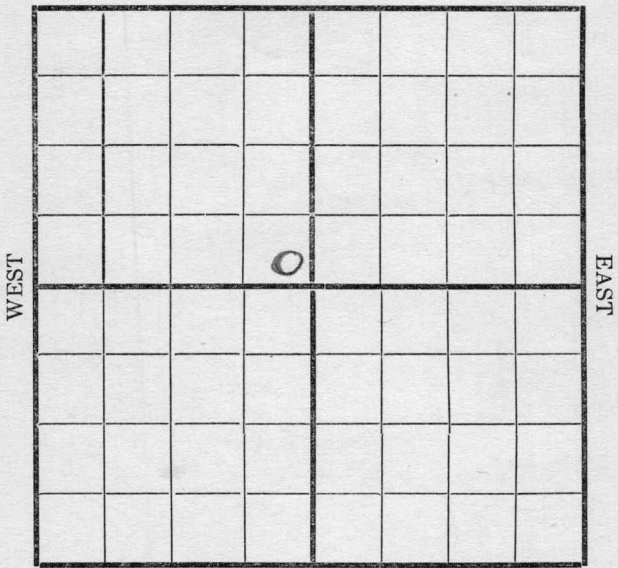

SOUTH


Location _____ Rig Up _____ Drilling and remarks <i>S.D. 1400</i>	RECORD
	Cased _____ in. _____ Ft.
	Sand _____
	Gas _____
	Oil _____
	Total Depth _____
	PRODUCTION
	1st 24 hrs. Nat. _____
	1st 24 hrs. after shot _____
	Gas _____ Cu. Ft.
	Dry Hole _____
	Abandoned _____

Date

R 2419171, 191____ *E. J. Crocker* Scout

Map No. _____ Sec. 2 Twp. 31 R. 9
 Well No. 1 Schull Farm
Hoyt et al Company

NORTH

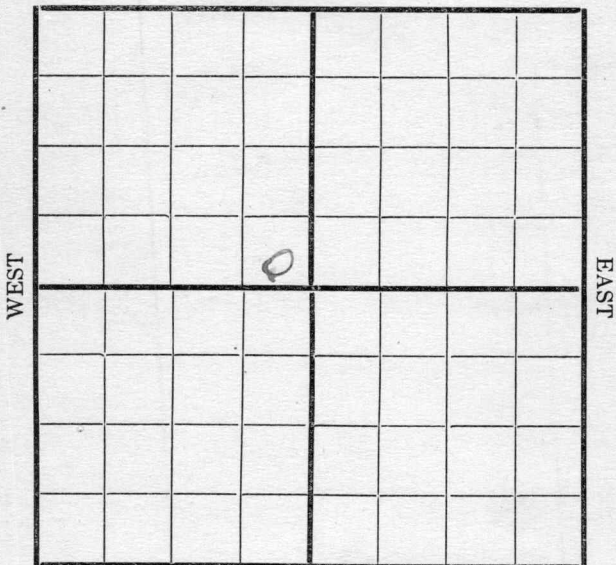

SOUTH

Location _____
 Rig Up _____
 Drilling and remarks _____

RECORD

Cased _____ in. _____ Ft.
 Sand _____
 Gas _____
 Oil _____
 Total Depth _____


PRODUCTION

1st 24 hrs. Nat. _____
 1st 24 hrs. after shot _____
 Gas _____ Cu. Ft.
 Dry Hole _____
 Abandoned _____

Date MAR 31 1917 C. J. Crook Scout

Map No. _____ Sec. 2 Twp. 31 R. 9
 Well No. 1 Schull Farm
Hoyt et al Company

NORTH

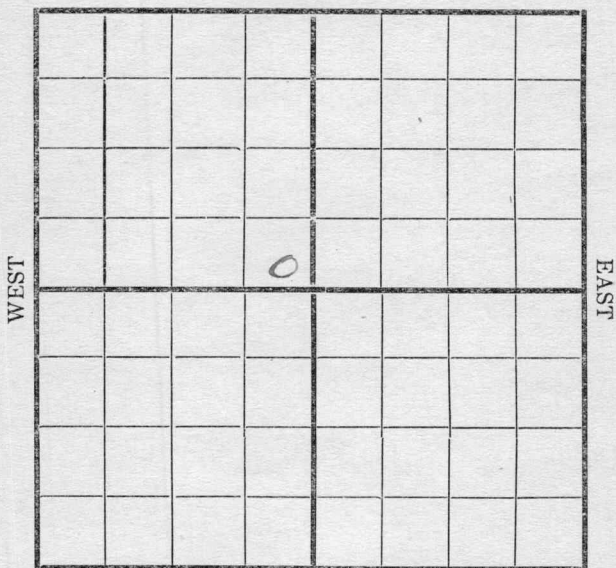

SOUTH

Location _____
 Rig Up _____
 Drilling and remarks _____

RECORD

Cased _____ in. _____ Ft.
 Sand _____
 Gas _____
 Oil _____
 Total Depth _____

PRODUCTION

1st 24 hrs. Nat. _____
 1st 24 hrs. after shot _____
 Gas _____ Cu. Ft.
 Dry Hole _____
 Abandoned _____

Date

APR 7 1911

C. J. Crocker.
 Scout


Elk.

Map No. _____ Sec. *2* Twp. *31* R. *9*

Well No. *1 Schull* Farm

Hoyt et al Company

NORTH

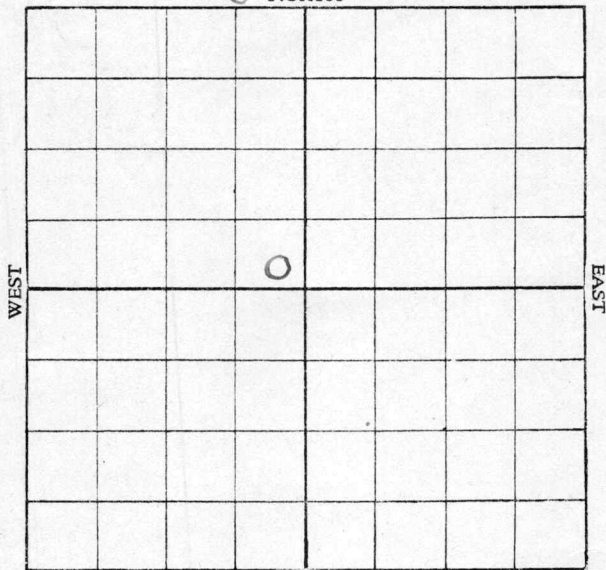

SOUTH

Location _____

Rig up _____

Drilling and remarks:

S.D. 1400'

RECORD

Cased _____ in. _____ Ft.

Sand _____

Gas _____

Oil _____

Total Depth _____

PRODUCTION

1st 24 hrs. Nat. _____

1st 24 hrs. after shot _____

Gas _____ Cu. Ft.

Dry Hole _____

Abandoned _____

Date

APR 14 1917


G. T. Crocker

Scout

Map No. _____ Sec. 2 Twp. 31 R. 9Well No. 1 Schull FarmHoyt et al Company

NORTH

WEST

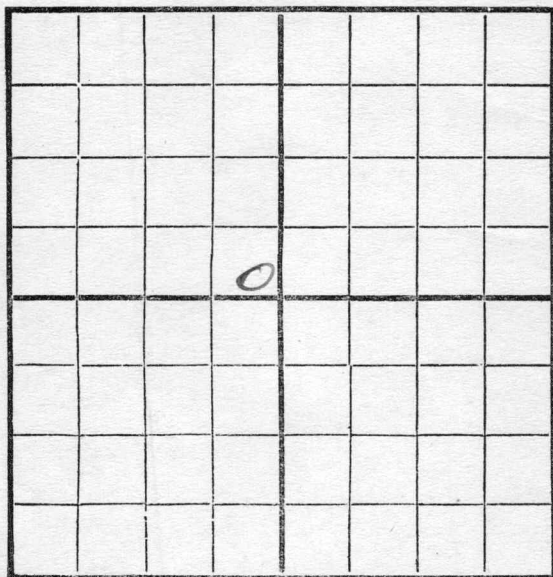

EAST

SOUTH

Location _____

Rig Up _____

Drilling and remarks

S.D. 1400

RECORD

Cased _____ in. _____ Ft.

Sand _____

Gas _____

Oil _____

Total Depth _____

PRODUCTION

1st 24 hrs. Nat. _____

First 24 hrs. after shot _____

Gas _____ Cu. Ft.

Dry Hole _____

Abandoned _____

Date


APR 21 1917

191

E. J. Crocker

Scout

Elk.
Map No. _____ Sec. 2 Twp. 31 R. 9
Well No. 1 Schull Farm
Hoyt & Co Company
NORTH

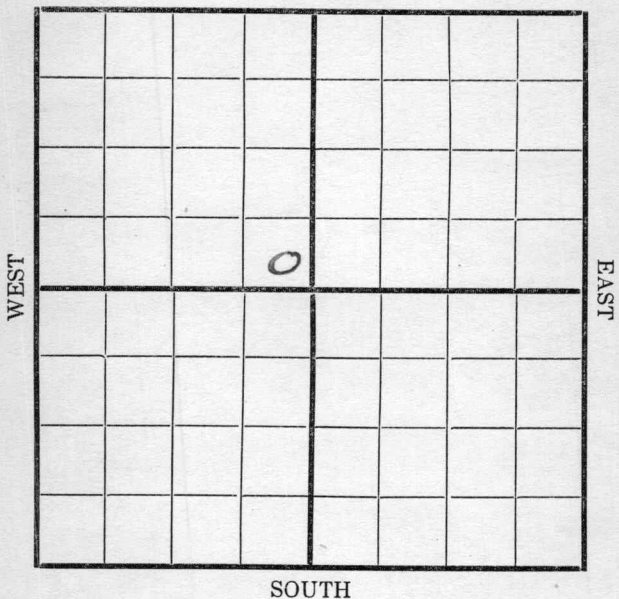

SOUTH

Location _____
Rig Up _____
Drilling and remarks _____

S.D. 1400

RECORD

Cased _____ in. _____ Ft.
Sand _____
Gas _____
Oil _____
Total Depth _____


PRODUCTION

1st 24 hrs. Nat. _____
1st 24 hrs. after shot _____
Gas _____ Cu. Ft.
Dry Hole _____
Abandoned _____

Date 4/28, 1917 Crocker Scout

Map No. K3 Sec. 2 Twp. 21 R. 9
 Well No. T. Schull
Hayes et al Company
 Contractor

NORTH

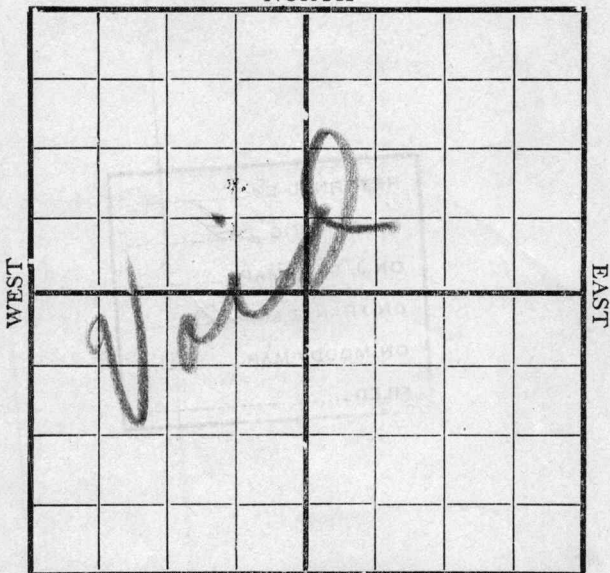

SOUTH

Location _____

Rig up _____

Drilling and Remarks:

J.D. 1400'

RECORD

Cased _____ in., _____ ft.

Sand _____

Gas _____

Oil _____

Total Depth _____

PRODUCTION

1st 24 hrs. Nat. _____

1st 24 hrs. after shot _____

Gas _____ Cu. Ft.

Dry Hole _____

Abandoned _____

Date 7/28 1917 Crocker Scout