


Section 12 Township 31 Range 9-E

Well Number 1 - Way

Company H. C. Teyrill

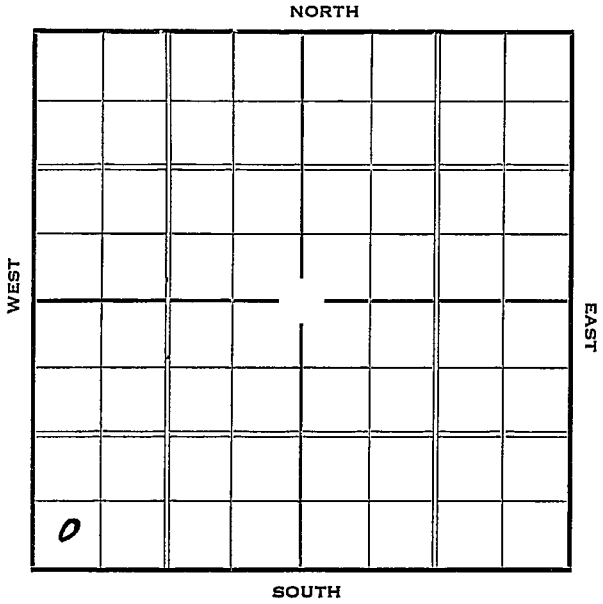

Sec. 12 Twp. 31 R. 9-E

Well No. #1 Way Farm


H. C. Teyrill Company

\_\_\_\_\_ Ft. from N. Line

330 Ft. from S. Line

\_\_\_\_\_ Ft. from E. Line

330 Ft. from W. Line

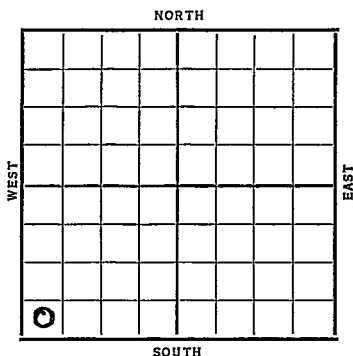

Date	REPORT
1937	
7/14	Drlg. 300'.
7/23	10" @ 608'. Drlg. 662'.
7/30	" " " " "
8/6	10" @ 795'. Drlg. 1100'.
8/13	10" @ 810'. 8" @ 1250'.
	Drlg. 1500'.
8/20	Drlg. 1980'.
8/28	" "
9/3	Miss. & 6" @ 2295'.
	T.D. 2335'. 4000 acid.
9/10	" " " " "
9/15	6" @ 2295'
	Miss 2295'
	TD 2335'
	4000 acid
	Pot 50
	COMPLETED

*Elk* KANSAS

Map No. 3 Sec. 17 Twp. 31 R. 9E

Well No. 1 - Way

H. C. Seyrill Company  
Contractor

FIRST REPORT

SECTION PLAT

\_\_\_\_\_ Ft. from N. Line

330 Ft. from S. Line

\_\_\_\_\_ Ft. from E. Line

330 Ft. from W. Line


Location \_\_\_\_\_

RECORD

Rig up \_\_\_\_\_

Drilling and Remarks:

*Ø/9 300*

Cased \_\_\_\_\_ in., \_\_\_\_\_ ft.

Sand \_\_\_\_\_

Gas \_\_\_\_\_

Oil \_\_\_\_\_

Total Depth \_\_\_\_\_

PRODUCTION

1st 24 hrs. Nat. \_\_\_\_\_

1st 24 hrs. after shot \_\_\_\_\_

Gas \_\_\_\_\_ Cu. Ft.

Dry Hole \_\_\_\_\_

Abandoned \_\_\_\_\_

Date

JUL 14 1937 19

**H. D. Hatfield**

Scout

*Elk* KANSAS

Map No. 3 Sec. 12 Twp. 31 R. 9E

Well No. 1 - J. C. Way

*H. C. Geyrill* Company  
Contractor

**SECTION PLAT**

**COMPLETED**

\_\_\_\_\_ Ft. from N. Line

330 Ft. from S. Line

\_\_\_\_\_ Ft. from E. Line

330 Ft. from W. Line

0			

Location \_\_\_\_\_

Rig up \_\_\_\_\_

Drilling and Remarks:

*4000 acid*

*Pat - 50*

**RECORD**

Cased 6 in., 2295 ft.

Sand MISS. 2295

Gas \_\_\_\_\_

Oil \_\_\_\_\_

Total Depth 2335

**PRODUCTION**

1st 24 hrs. Nat. \_\_\_\_\_

1st 24 hrs. after shot \_\_\_\_\_

Gas \_\_\_\_\_ Cu. Ft.

Dry Hole \_\_\_\_\_

Abandoned \_\_\_\_\_

Date

**SEP 15 1937** 19

H. D. Hatfield Scout