


Elk

Form 51-5M-11-31-Palace

Map No. **KANSAS** Sec. 5 Twp. 31 R. 10^E

Well No. 4 Walker Farm
Harry Jones Company

NORTH

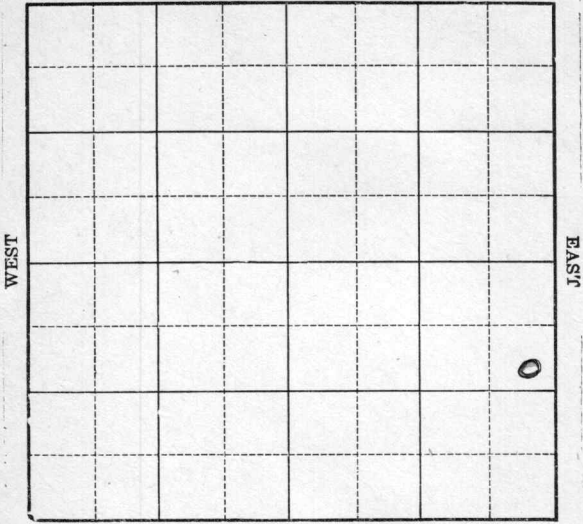

SOUTH

Location _____
Drilling Remarks _____

Rig Up _____
Drilling Remarks _____

RECORD

PRODUCTION

Cased _____ in. _____ ft.

Sand _____

Gas _____

Oil _____

Total Depth _____

1st 24 hrs. Nat. _____

1st 24 hrs. after shot _____

Gas _____ cu. ft.

Dry Hole _____

Abandoned _____

Map No. 4 Sec. 5 Twp. 31 R. 10 E

Well No. 4 - Walker

Harry Jones Company

Contractor

FIRST REPORT

SECTION PLAT

1070 Ft. from N. Line

_____ Ft. from S. Line

250 Ft. from E. Line

_____ Ft. from W. Line

			○

Location _____

Rig up _____

Drilling and Remarks:

Rgn machine

RECORD

Cased _____ in., _____ ft.

Sand _____

Gas _____

Oil _____

Total Depth _____

PRODUCTION

1st 24 hrs. Nat. _____

1st 24 hrs. after shot _____

Gas _____ Cu. Ft.

Dry Hole _____

Abandoned _____

Date

4-18-31 19

ORVAL MANNSCHRECK

Scout

Map No. 4 ^{KANSAS} Sec. 5 Twp. 31 R. 10E

Well No. 4 Walker

Harry Jones Company

Contractor

SECTION PLAT

	COMPLETE		
			0

1070 Ft. from N. Line

_____ Ft. from S. Line

250 Ft. from E. Line

_____ Ft. from W. Line

Location _____

RECORD

Cased _____ in., _____ ft.

Sand _____

Gas _____

Oil _____

Total Depth 1573

PRODUCTION

1st 24 hrs. Nat. _____

1st 24 hrs. after shot _____

Gas _____ Cu. Ft.

Dry Hole _____

Abandoned _____

Date

5/30 1934

ORVAL MANNSCHRECK
Scout

Pay 1542-55

Pump 288 x 1/2