


Section 5 Township 31 Range 10-E

Well No. 7 Walker

Company W. H. Jones

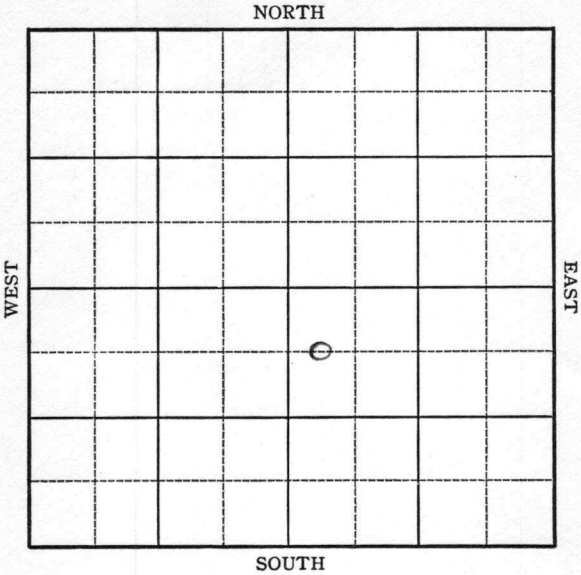

KANSAS

Elk

Map No. 4 Sec. 5 Twp. 31 R. 10EWell No. 7 WalkerW. H. Jones

Company

Contractor

FIRST REPORT

C W L NW SE

660

Ft. from N. Line

Ft. from S. Line

Ft. from E. Line

330

Ft. from W. Line

SECTION PLAT

		0	

Location _____

RECORD

Cased _____ in., _____ ft.

Sand _____

Gas _____

Oil _____

Total Depth _____

Rig up _____

Drilling and Remarks:

10 - 585

8 - 935

KC -1601

S.O.2032 - 50

Dr1g. 2190

PRODUCTION

1st 24 hrs. Nat. _____

1st 24 hrs. after shot _____

Gas _____ Cu. Ft.

Dry Hole _____

Abandoned _____

Date

OCT 13 1937 19H. D. Hatfield Scout

Elk

KANSAS

Map No. 3 Sec. 5 Twp. 31 R. 10EWell No. 7 WalkerW. H. Jones

Company

COMPLETED

Contractor

SECTION PLAT

C W L NW SE

660 Ft. from N. Line Ft. from S. Line Ft. from E. Line330 Ft. from W. Line

		0	

A

Location Rig up

Drilling and Remarks:

1000 andPT 15

RECORD

Cased 6 in., 2203 ft.Sand Miss 2203Gas Oil Total Depth 2223

PRODUCTION

1st 24 hrs. Nat. 1st 24 hrs. after shot Gas Cu. Ft.Dry Hole Abandoned

Date

NOV 10 1937 19H. D. Hatfield

Scout