

Map No. **KANSAS** Sec. ~~18~~ Twp. 31 R. 10

Well No. 1- Blk 40 Lot 10 Farm


Torrey & Murphy Company

..... Ft. from N. Line

1120 Ft. from S. Line

..... Ft. from E. Line

1120 Ft. from W. Line

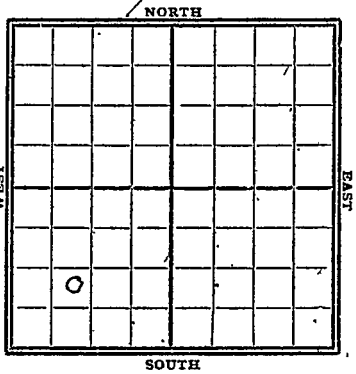

1928

Date

REPORT

11/17	Rigging up
11/14	20 bbls 400'
11/21	" 955'
11/28	" 1800'
12/5	sand 1974'-2009'
	shot 120 gts - Blowout
12/12	sand 1974-2009
	T.D. 2009
	shot 120 gts
	30 bbls oil
	Completed

K4 KANSAS
 MAP NO. _____ SEC. 10 TWP. 31 R. 10
 WELL NO. 1 Bk 40 lot 10
Toney & Murphy COMPANY

CONTRACTOR

SECTION PLAT

CORRECTIO

0			

_____ FT. FROM N. LINE

1170 FT. FROM S. LINE

_____ FT. FROM E. LINE

1170 FT. FROM W. LINE

RECORD

CASED _____ IN. _____ FT.

SAND _____

GAS _____

OIL _____

TOTAL DEPTH _____

PRODUCTION

1ST 24 HRS. NAT. _____

1ST 24 HRS. AFTER SHOT _____

GAS _____ CU. FT.

DRY HOLE _____

ABANDONED _____

LOCATION _____

RIG UP By 400'

DRILLING AND REMARKS:

Prod reported
in Sec 16.
Chg to Sec 10.

DATE
 NOV 14 1928

CHAS. L. SHERWOOD

192 _____ SCOUT

K4 KANSAS *Exp*
 Map No. _____ Sec. *10* Twp. *31* R. *10*

Well No. *1 Bls 40 lot 10*

Jervey & Murgins Company

Contractor _____

COMPLETED

SECTION PLAT

_____ Ft. from N. Line

1120 Ft. from S. Line

_____ Ft. from E. Line

1120 Ft. from W. Line

<i>0</i>			

Location _____

Rig up _____

Drilling and Remarks:

120/30 Bls.

RECORD

Cased _____ in., _____ ft.

Sand *1974-7009*

Gas _____

Oil _____

Total Depth *7009*

PRODUCTION

1st 24 hrs. Nat. _____

1st 24 hrs. after shot _____

Gas _____ Cu. Ft.

Dry Hole _____

Abandoned _____

Date

DEC 12 1928

CHAS. L. SHERWOOD

192

Scout