


Map No. KANSAS Sec. 10 Twp. 31 R. 10
Well No. 1- Bills 44 lot 3 Farm
Donner Gas Co Company

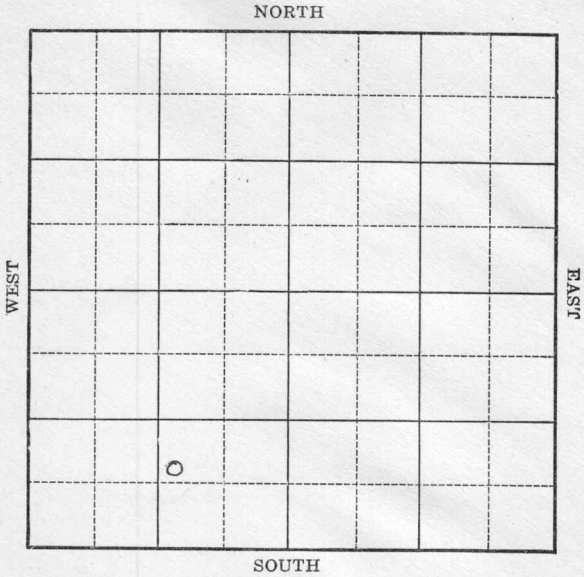

Location _____

Rig Up _____

Drilling Remarks _____

Drilling Remarks _____

RECORD

PRODUCTION

Cased _____ in. _____ ft.

1st 24 hrs. Nat. _____

Sand _____

1st 24 hrs. after shot _____

Gas _____

Gas _____ cu. ft.

Oil _____

Dry Hole _____

Total Depth _____

Abandoned _____

Map No. KANSAS Sec. 10 Twp. 31 R. 10


Well No. 1- B1K 44 Lot 3 Farm
Southern Gas Co Company

.....Ft. from N. Line

700 Ft. from S. Line

.....Ft. from E. Line

1400 Ft. from W. Line

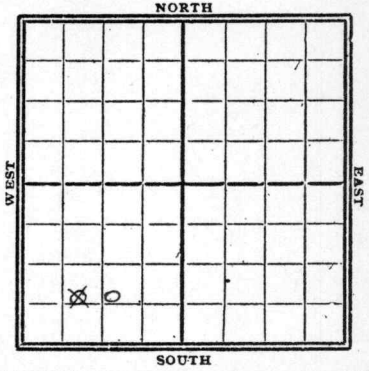

1928

Date	REPORT
10/17	Rigged up.
10/24	Spdg 100'
10/31	2 Orly 560'
11/7	" 950'
11/14	" 1460'
11/21	fsg 1600'
11/28	sand 1981-2006'
	spraying oil
12/15	fsg casing
12/12	_____
12/19	_____
12/26	_____
1929	
1/2	_____
1/9	_____
1/16	sand 1981'-2006'
	T.D. 2006'
	shot 80 gts
	75 bbls oil
	Completed

K4 KANSAS

MAP NO. _____ SEC. 10 TWP. 31 R. 10

WELL NO. 1 Bly 44 Lot 3

Sonner & Son Co COMPANY

CONTRACTOR

SECTION PLAT

FIRST REPORTS

	0		

_____ FT. FROM N. LINE

700 FT. FROM S. LINE

_____ FT. FROM E. LINE

1400 FT. FROM W. LINE

LOCATION _____

RIG UP _____

DRILLING AND REMARKS: *logging up*

RECORD

CASED _____ IN., _____ FT.

SAND _____

GAS _____

OIL _____

TOTAL DEPTH _____

PRODUCTION

1ST 24 HRS. NAT. _____

1ST 24 HRS. AFTER SHOT _____

GAS _____ CU. FT.

DRY HOLE _____

ABANDONED _____

DATE

OCT 17 1928

CHAS. L. SHERWOOD

192

Scout

44 KANSAS SEC. 10 TWP. 31 R. 10

WELL No. 1 Blk 44 Lot 3
Somers Gas Co COMPANY

CONTRACTOR

COMPLETE

SECTION PLAT

_____ FT. FROM N. LINE
700 FT. FROM S. LINE
_____ FT. FROM E. LINE
1400 FT. FROM W. LINE

	0		

LOCATION _____

RIG UP _____

DRILLING AND REMARKS:

80/75 Blk.

RECORD

CASED _____ IN. _____ FT.
SAND 1981-2006
GAS _____
OIL _____
TOTAL DEPTH 2006

PRODUCTION

1ST 24 HRS. NAT. _____
1ST 24 HRS. AFTER SHOT _____
GAS _____ CU. FT.
DRY HOLE _____
ABANDONED _____

DATE

JAN 16 1929

CHAS. L. SHERWOOD

192

SCOUT