



Map No. **KANSAS** Sec. 10 Twp. 31 R. 10

Well No. 2 - Baker Farm

Shirman & Austin Company


NORTH

1195 Ft. from N. Line

\_\_\_\_\_ Ft. from S. Line

\_\_\_\_\_ Ft. from E. Line

525 Ft. from W. Line

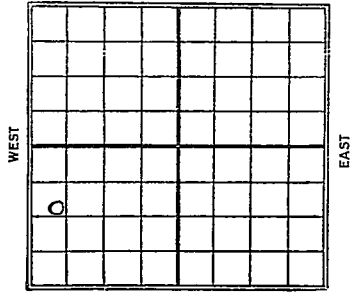

SOUTH

1928

Date

REPORT

<u>5/24</u>	<u>10 bbl gas 650'</u>
<u>5/31</u>	<u>1/2 bbl gas 1150' 10 bbl 1360'</u>
<u>6/7</u>	<u>10 bbl 1540'</u>
<u>6/12</u>	<u>1982-2010 TD 2010</u>
	<u>80/75 bbls</u>

**4 KANSAS**

*Tele 31 10*

MAP NO. \_\_\_\_\_ SEC. 10 TWP. 31 R. 10

WELL NO. 2 Baker

Sherman & Austin Co COMPANY

CONTRACTOR

**FIRST REPORTS**

**SECTION PLAT**

1195 FT. FROM N. LINE  
 \_\_\_\_\_ FT. FROM S. LINE  
 \_\_\_\_\_ FT. FROM E. LINE  
525 FT. FROM W. LINE

0			

LOCATION \_\_\_\_\_

RIG UP \_\_\_\_\_

DRILLING AND REMARKS:

*log 650*

**RECORD**

CASED \_\_\_\_\_ IN., \_\_\_\_\_ FT.  
 SAND \_\_\_\_\_  
 GAS \_\_\_\_\_  
 OIL \_\_\_\_\_  
 TOTAL DEPTH \_\_\_\_\_

**PRODUCTION**

1ST 24 HRS. NAT. \_\_\_\_\_  
 1ST 24 HRS. AFTER SHOT \_\_\_\_\_  
 GAS \_\_\_\_\_ CU. FT.  
 DRY HOLE \_\_\_\_\_  
 ABANDONED \_\_\_\_\_

DATE  
**MAY 24 1928**

**CHAS. L. SHERWOOD**

*4-11-10*

**4 KANSAS**

MAP No. \_\_\_\_\_ SEC. 10 TWP. 31 R. 10

WELL No. 2 Baker

Sherman & Austin Oil COMPANY

CONTRACTOR

**COMPLETED**

**SECTION PLAT**

1195 FT. FROM N. LINE

\_\_\_\_\_ FT. FROM S. LINE

\_\_\_\_\_ FT. FROM E. LINE

525 FT. FROM W. LINE

0			

LOCATION \_\_\_\_\_

RIG UP \_\_\_\_\_

DRILLING AND REMARKS:

80775 Bbs.

**RECORD**

CASED \_\_\_\_\_ IN. \_\_\_\_\_ FT.

SAND 1982-2010

GAS \_\_\_\_\_

OIL \_\_\_\_\_

TOTAL DEPTH 2010

**PRODUCTION**

1ST 24 HRS. NAT. \_\_\_\_\_

1ST 24 HRS. AFTER SHOT \_\_\_\_\_

GAS \_\_\_\_\_ CU. FT.

DRY HOLE \_\_\_\_\_

ABANDONED \_\_\_\_\_

DATE

JUN 13 1928

**CHAS. L. SHERWOOD**

192

SCOUT