



Elk

Form 252-A  
5M 4-32 MPC

Map No. KANSAS Sec. 10 Twp. 31 R. 10<sup>E</sup>

Well No. 4 Baker Farm


Sherman et al Company

35 Ft. from N. Line

\_\_\_\_\_ Ft. from S. Line

\_\_\_\_\_ Ft. from E. Line

150 Ft. from W. Line

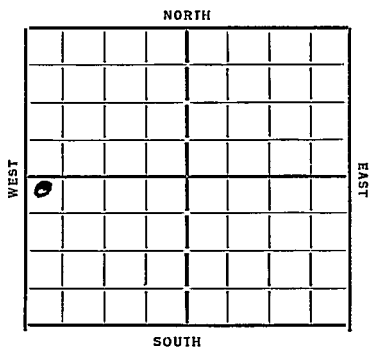

Date 1984

REPORT

6/13 dy 520

6/21 \_\_\_\_\_

6/28 SD 520

7/5 8" 1450 6" 1975

oil 1983-95 T Miss 1975

7/11 T Miss 1975 TD 2009

40 oil 10 water

COMPLETED

KANSAS

Map No. 4 Sec. 10 Twp. 31 R 10 E

Well No. 4 - Baker

Sherman et al Company

Contractor

FIRST REPORT

SECTION PLAT

35 Ft. from N. Line

\_\_\_\_\_ Ft. from S. Line

\_\_\_\_\_ Ft. from E. Line

150 Ft. from W. Line

⊙			

Location \_\_\_\_\_

Rig up \_\_\_\_\_

Drilling and Remarks:

Well 520

RECORD

Cased \_\_\_\_\_ in., \_\_\_\_\_ ft.

Sand \_\_\_\_\_

Gas \_\_\_\_\_

Oil \_\_\_\_\_

Total Depth \_\_\_\_\_

PRODUCTION

1st 24 hrs. Nat. \_\_\_\_\_

1st 24 hrs. after shot \_\_\_\_\_

Gas \_\_\_\_\_ Cu. Ft.

Dry Hole \_\_\_\_\_

Abandoned \_\_\_\_\_

Date

6-13-37<sub>19</sub>

ORVAL MANNSCHRECK

Scout

Map No. 4 Sec. 10 Twp. 31 R. 10 <sup>2</sup>

Well No. 4-Baker

Sherman et al Company

Contractor

**COMPLETED**

**SECTION PLAT**

35 Ft. from N. Line  
 \_\_\_\_\_ Ft. from S. Line  
 \_\_\_\_\_ Ft. from E. Line  
150 Ft. from W. Line

<u>0</u>			

Location \_\_\_\_\_

Rig up \_\_\_\_\_

Drilling and Remarks:

40 oil  
10 water

**RECORD**

Cased \_\_\_\_\_ in., \_\_\_\_\_ ft.

Sand T. Miss 1975

Gas \_\_\_\_\_

Oil \_\_\_\_\_

Total Depth 2009

**PRODUCTION**

1st 24 hrs. Nat. \_\_\_\_\_

1st 24 hrs. after shot \_\_\_\_\_

Gas \_\_\_\_\_ Cu. Ft.

Dry Hole \_\_\_\_\_

Abandoned \_\_\_\_\_

Date

7-11-37 19

D. Mansch Scout