


Map No. CLK KANSAS Sec. 10 Twp. 31 R. 10
 Well No. 1- Blk 46- Lot 3 Farm craft & Hunt Company

NORTH

WEST

EAST

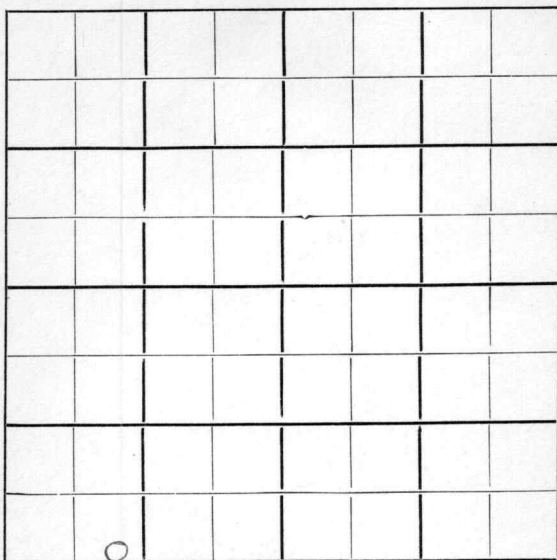

SOUTH

Location.....

Rig Up.....

Drilling Remarks

Drilling Remarks

.....

.....

RECORD

PRODUCTION

Cased.....in.....ft.

1st 24 hrs. Nat.....

Sand.....

1st 24 hrs. after shot.....

Gas.....

Gas.....cu. ft.....

Oil.....

Dry Hole.....

Total Depth.....

Abandoned.....

Map No. **KANSAS** Sec. 10 Twp. 31 R. 10

Well No. 1 - B1k 46 Lot 3 Farm

Groff & Hunt Company


.....Ft. from N. Line

50 Ft. from S. Line

Ft. from E. Line

1120 Ft. from W. Line

1928.

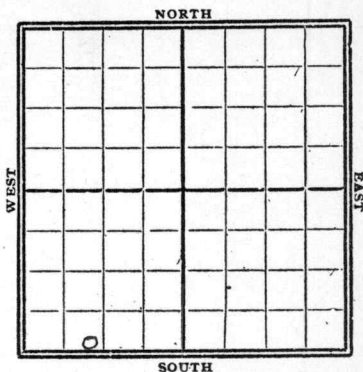

Date _____

REPORT

10/31	Rigging up
11/7	Drill 500'
11/14	" 1150'
11/21	" 1630'
11/28	sand 1981-2015'- 1500' oil in hole Will shoot
12/5	sand 1981-2015' T.D. 2015' shot 80 gts made 100 bbls oil Soup.

K9 KANSAS

MAP No. _____ SEC. 10 TWP. 31 R. 10

WELL No. 1 Blk 46 Lot 3

Crest & Hunt COMPANY

CONTRACTOR

SECTION PLAT

FIRST REPORTS

_____ FT. FROM N. LINE

50 _____ FT. FROM S. LINE

_____ FT. FROM E. LINE

1120 _____ FT. FROM W. LINE

0			

LOCATION _____

RIG UP _____

DRILLING AND REMARKS:

Rigging up

RECORD

CASED _____ IN. _____ FT.

SAND _____

GAS _____

OIL _____

TOTAL DEPTH _____

PRODUCTION

1ST 24 HRS. NAT. _____

1ST 24 HRS. AFTER SHOT _____

GAS _____ CU. FT.

DRY HOLE _____

ABANDONED _____

DATE

OCT 31 1928

CHAS. L. SHERWOOD

192

SCOUT

144 KANSAS

MAP No. _____ SEC. 10 TWP. 31 R. 10WELL No. 1 Blk 46 lot 3Crest & Hunt

COMPANY _____

CONTRACTOR _____

SECTION PLAT

COMPLETED

Ft. FROM N. LINE50
Ft. FROM S. LINE_____
Ft. FROM E. LINE1120
Ft. FROM W. LINE

0			

LOCATION _____

RIG UP _____

DRILLING AND REMARKS:

80/100 Blk.

RECORD

CASED _____ IN. _____ FT.

SAND 1981-2015

GAS _____

OIL _____

TOTAL DEPTH 2015

PRODUCTION

1ST 24 HRS. NAT. _____

1ST 24 HRS. AFTER SHOT _____

GAS _____ CU. FT.

DRY HOLE _____

ABANDONED _____

DATE

DEC 5 1928

CHAS. L. SHERWOOD

192

SCOUT