

Elk


Form 51-5M-4-27-27423

Map No. KANSAS Sec. 10 Twp. 31 R. 10

Well No. 1-BH 47 Lot 2 Farm

Croft & Hunt Company

NORTH

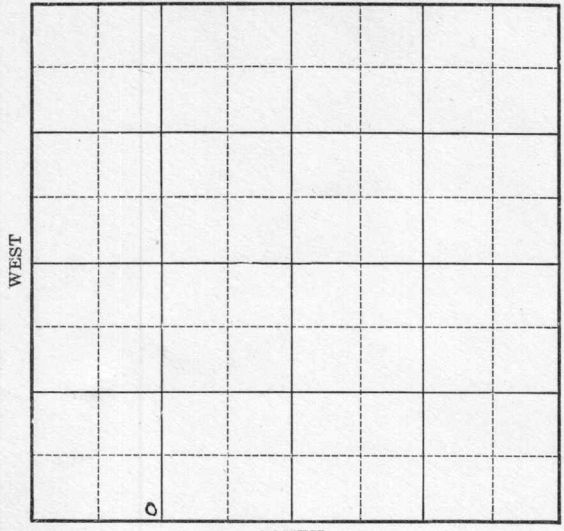

Location _____

Drilling Remarks _____

Rig Up _____

Drilling Remarks _____

RECORD

Cased _____ in. _____ ft.

Sand _____

Gas _____

Oil _____

Total Depth _____

PRODUCTION

1st 24 hrs. Nat. _____

1st 24 hrs. after shot _____


Gas _____ cu. ft.

Dry Hole _____

Abandoned _____

Map No. KANSAS Sec. 10 Twp. 31 R. 10
 Well No. 1 Blk 47 Lot 2 Farm
Croft & Hunt Company

_____ Ft. from N. Line
100 Ft. from S. Line
 _____ Ft. from E. Line
1250 Ft. from W. Line

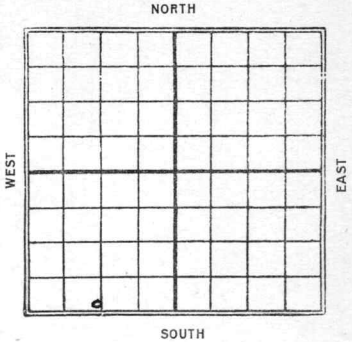

1928

Date	REPORT
9/19	Bldg Rig
9/26	Rig up
10/3	Spudding 150'
10/10	Drily 560'
10/17	setg 8" - 1500'
10/24	sand 1990-2020' swab 100 bbls
10/31	sand 1984-2023' T.D. 2023'
	shot 120 gts
	125 bbls oil
	Gomp

K4 KANSAS

MAP No. _____ SEC. 10 TWP. 31 R. 10

WELL No. 1 Bks 47 Lot 2

Crout & Hunt

COMPANY

CONTRACTOR

FIRST REPORTS

SECTION PLAT

_____ FT. FROM N. LINE

100 FT. FROM S. LINE

_____ FT. FROM E. LINE

1750 FT. FROM W. LINE

LOCATION Blog Rig

RIG UP _____

DRILLING AND REMARKS:

RECORD

CASED _____ IN., _____ FT.

SAND _____

GAS _____

OIL _____

TOTAL DEPTH _____

PRODUCTION

1ST 24 HRS. NAT. _____

1ST 24 HRS. AFTER SHOT _____

GAS _____ CU. FT.

DRY HOLE _____

ABANDONED _____

DATE

SEP 19 1928

CHAS. L. SHERWOOD

192

SCOUT

Elk

K9 KANSAS

MAP No. _____ SEC. 10 TWP. 31 R. 10

WELL No. 1 Bly 47 Lot 2

Crest & Hunt

COMPANY _____

CONTRACTOR _____

COMPLETED

SECTION PLAT

<i>0</i>			

_____ FT. FROM N. LINE

100 FT. FROM S. LINE

_____ FT. FROM E. LINE

1250 FT. FROM W. LINE

LOCATION _____

RIG UP _____

DRILLING AND REMARKS:

1207 125 Bl.

RECORD

CASED _____ IN. _____ FT.

SAND 1984-2023

GAS _____

OIL _____

TOTAL DEPTH 2023

PRODUCTION

1ST 24 HRS. NAT. _____

1ST 24 HRS. AFTER SHOT _____

GAS _____ Cu. Ft.

DRY HOLE _____

ABANDONED _____

DATE

OCT 31 1928

CHAS. L. SHERWOOD

192

SCOUT