



Map No. K Sec. 25 Twp. 28 R. 5

Well No. 1 Spudling Farm  
Sterling O. R. Company


NORTH

Ft. from N. Line

200 Ft. from S. Line

Ft. from E. Line

200 Ft. from W. Line

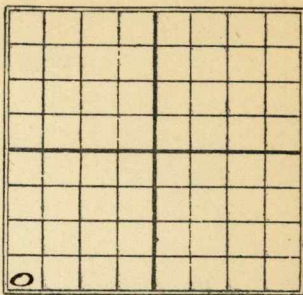

SOUTH

Date 1/3/32

REPORT

1/3


Some gas del 2737-48  
chale 2749-77-del  
sand 2777-91 - shot  
90 yds / 110 bbls.

Map No. 11 Sec. 25 Twp. 28 R. 5

Well No. Stirling O. & R. Farm \_\_\_\_\_  
Company \_\_\_\_\_

Date Started \_\_\_\_\_ Ft. from N. S 200 E. W 200 line

NORTH Kansas

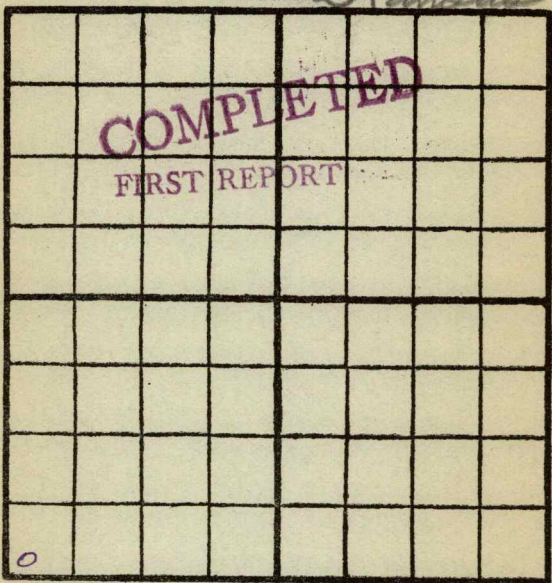

SOUTH

Cased \_\_\_\_\_ In. \_\_\_\_\_ Ft.

Production Remarks

Sand \_\_\_\_\_

Pay { Gas \_\_\_\_\_  
Oil \_\_\_\_\_

Total Depth \_\_\_\_\_

Condition of Well on this date \_\_\_\_\_

*some Gas & oil - 2737-49, shall  
2749-77' oil sand - 2777-91  
shot - 90 g to 110 fbs.*

*Completed*

M. A. BENEAR

Scout