


Map No. KANSAS Sec. 10 Twp. 31 R. 10

Well No. 1 Cook Farm
C. H. England Company

990 Ft. from N. Line
 _____ Ft. from S. Line
 _____ Ft. from E. Line
250 Ft. from W. Line

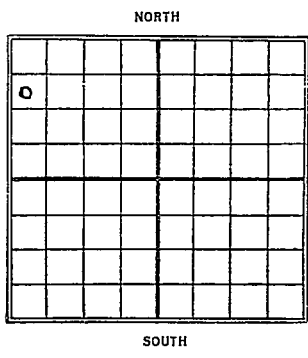

1928

Date	REPORT
9/5	Location
9/12	Drly 495'
9/19	S.D. 600'
9/26	_____
10/3	Drly 824'
10/10	" 1450'
10/17	Top sand 2002-2008' running 6"
10/24	sand 2002-2041' T.D. 2041'
	shot 120 gts
	150 bbls oil
	<u>Sump</u>

K4 KANSAS

MAP NO. _____ SEC. 10 TWP. 31 R. 10

WELL No. 1

C. S. England COMPANY

CONTRACTOR

FIRST REPORTS

SECTION PLAT

990 FT. FROM N. LINE

_____ FT. FROM S. LINE

_____ FT. FROM E. LINE

250 FT. FROM W. LINE

0			

LOCATION ✓

RIG UP _____

DRILLING AND REMARKS:

RECORD

CASED _____ IN. _____ FT.

SAND _____

GAS _____

OIL _____

TOTAL DEPTH _____

PRODUCTION

1ST 24 HRS. NAT. _____

1ST 24 HRS. AFTER SHOT _____

GAS _____ CU. FT.

DRY HOLE _____

ABANDONED _____

DATE SEP 5 1928

CHAS. L. SHERWOOD

192

SCOUT

Wells
K4 KANSAS SEC. 10 TWP. 31 R. 10
 MAP NO. _____

WELL No. 1 *Cook*
C. S. England COMPANY

CONTRACTOR _____

SECTION PLAT

COMPLETED

0			

990 FT. FROM N. LINE

_____ FT. FROM S. LINE

_____ FT. FROM E. LINE

250 FT. FROM W. LINE

LOCATION _____

RIG UP _____

DRILLING AND REMARKS:

1207150 P.S.

RECORD

CASED 2 IN. _____ FT.

SAND 2002-2041

GAS _____

OIL _____

TOTAL DEPTH 2041

PRODUCTION

1ST 24 HRS. NAT. _____

1ST 24 HRS. AFTER SHOT _____

GAS _____ CU. FT.

DRY HOLE _____

ABANDONED _____

DATE

OCT 24 1928

CHAS. L. SHERWOOD

192

SCOUT