


Kansas

Map No. _____ Sec. 26 Twp. 28 R. 15

Well No. 4 Bonnell Farm _____
Jidal Company _____

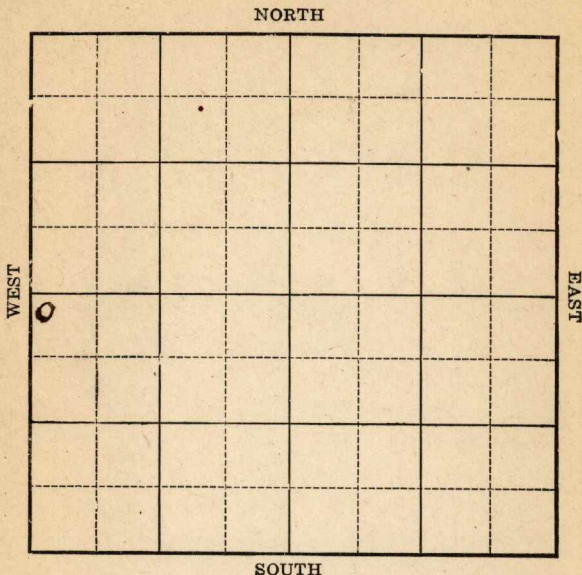

FIRST REPORT

Location _____

Drilling Remarks:

Rig Up COMPLETED

Drilling Remarks:

RECORD

Cased _____ in. _____ ft.

Sand _____

Gas _____

Oil _____

Total Depth _____

PRODUCTION

1st 24 hrs. Nat. _____

1st 24 hrs. after shot _____

Gas _____ cu. ft.

Dry Hole _____

Abandoned _____

Map No. _____ Sec. 26 Twp. 28 R. 5


Well No. # 4 Bonnell Farm
Tidal Company

200 Ft. from N. Line

_____ Ft. from S. Line

_____ Ft. from E. Line

200 Ft. from W. Line

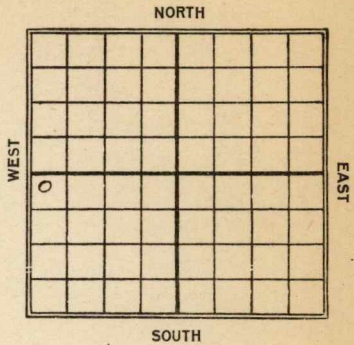

Date	REPORT
1922	
8/13	Dig
11/24	D. 49.2890'

Map No. 26 Sec. 26 Twp. 27 R. 3Well No. 4Tidal Company

Contractor

FIRST REPORT

200 Ft. from N. Line

Ft. from S. Line

Ft. from E. Line

200 Ft. from W. Line

SECTION PLAT

Location

Rig up

Drilling and Remarks:

Rig,

RECORD

Cased _____ in., _____ ft.

Sand _____

Gas _____

Oil _____

Total Depth _____

PRODUCTION

1st 24 hrs. Nat. _____

1st 24 hrs. after shot _____

Gas _____ Cu. Ft.

Dry Hole _____

Abandoned _____

Date

AUG 13 1922

M. A. BENEAR

191 Scout

Map No. **KANSAS** 11 26 28 5 Sec. Twp. R.

Well No. 4 Bonnell

Tidal Company

Contractor

ABANDONED SECTION PLAT

200 Ft. from N. Line

Ft. from S. Line

Ft. from E. Line

200 Ft. from W. Line

0			

Location

Rig up

Drilling and Remarks:

show 2812

RECORD

Cased in., ft.

Sand

Gas

Oil

Total Depth

PRODUCTION

1st 24 hrs. Nat.

1st 24 hrs. after shot

Gas Cu. Ft.

Dry Hole

Abandoned 2890

Date

NOV 24 1922 191

M. A. BENEAR Scout