


Map No. KANSAS Sec. 19 Twp. 31 R. 10

Well No. D. Palmer Farm
O. Dell et al Company

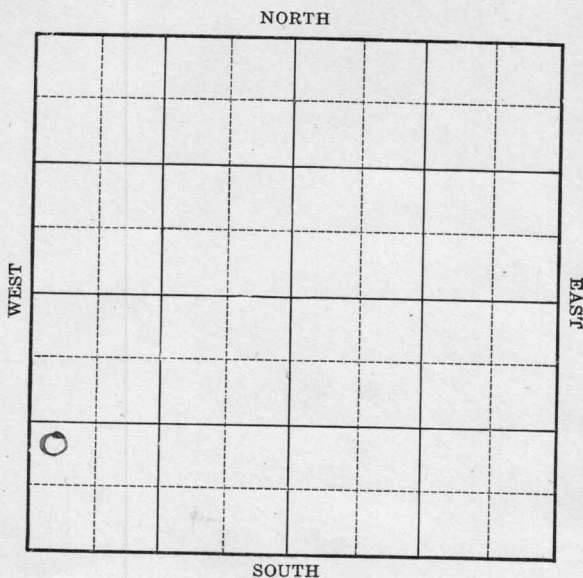

Location _____

Drilling Remarks _____

Rig Up _____

Drilling Remarks _____

RECORD

Cased _____ in. _____ ft.

Sand _____

Gas _____

Oil _____

Total Depth _____

PRODUCTION

1st 24 hrs. Nat. _____

1st 24 hrs. after shot _____

Gas _____ cu. ft.

Dry Hole _____

Abandoned _____

Map No. KANSAS Sec. 10 Twp. 31 R. 10
 Well No. 1-Palmer Farm
Odell et al Company


.....Ft. from N. Line

1120 Ft. from S. Line

.....Ft. from E. Line

250 Ft. from W. Line

1928

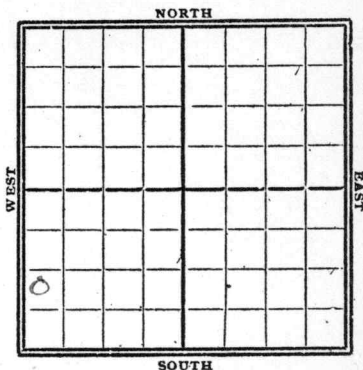

Date

REPORT

Date	REPORT
7/13	Rig'n up
7/19	Drly - 350
7/26	
8/2	" 650
8/9	" 1150
8/16	Fig. 1800
8/23	sand 1974-2006 shot 70qt - Clq out
8/28	fig. csq.
9/5	sand 1974-2006 T.D. - 2006 70/50 bbls. <u>Comp</u>

MAP NO. K4 Kansas SEC. 10 TWP. 31 R. 10

WELL NO. 1 Palmer - Moline Junction

Debel et al COMPANY

CONTRACTOR

SECTION PLAT

FIRST REPORTS

_____ FT. FROM N. LINE

1120 FT. FROM S. LINE

_____ FT. FROM E. LINE

750 FT. FROM W. LINE

0			

LOCATION _____

RIG UP _____

DRILLING AND REMARKS:

Bigging up

RECORD

CASED _____ IN., _____ FT.

SAND _____

GAS _____

OIL _____

TOTAL DEPTH _____

PRODUCTION

1ST 24 HRS. NAT. _____

1ST 24 HRS. AFTER SHOT _____

GAS _____ CU. FT.

DRY HOLE _____

ABANDONED _____

DATE _____

7/13/28 192

Sherwood SCOUT

K4 KANSAS MAP NO. _____ SEC. 10 TWP. 31 R. 10

WELL NO. Palmer
Bell et al COMPANY

CONTRACTOR

SECTION PLAT

COMPLETED

_____ FT. FROM N. LINE

1120 FT. FROM S. LINE

_____ FT. FROM E. LINE

250 FT. FROM W. LINE

0			

LOCATION _____

RIG UP _____

DRILLING AND REMARKS:

707/50 lbs.

RECORD

CASED _____ IN. _____ FT.

SAND 1974-2006

GAS _____

OIL _____

TOTAL DEPTH 2006

PRODUCTION

1ST 24 HRS. NAT. _____

1ST 24 HRS. AFTER SHOT _____

GAS _____ CU. FT.

DRY HOLE _____

ABANDONED _____

DATE SEP 5 1928

CHAS. L. SHERWOOD