


Map No. \_\_\_\_\_ Sec. 26 Twp. 28 R. 5

Well No. 7 Bonnell Farm \_\_\_\_\_  
Jidal Company \_\_\_\_\_

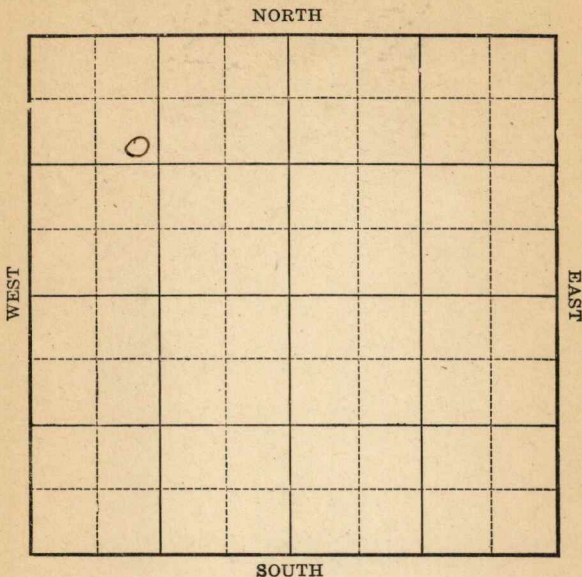

Location \_\_\_\_\_

Drilling Remarks:

\_\_\_\_\_

\_\_\_\_\_

Rig Up \_\_\_\_\_

Drilling Remarks:

\_\_\_\_\_

\_\_\_\_\_

**RECORD**

Cased \_\_\_\_\_ in. \_\_\_\_\_ ft.

Sand \_\_\_\_\_

Gas \_\_\_\_\_

Oil \_\_\_\_\_

Total Depth \_\_\_\_\_

**PRODUCTION**

1st 24 hrs. Nat. \_\_\_\_\_

1st 24 hrs. after shot \_\_\_\_\_

Gas \_\_\_\_\_ cu. ft.

Dry Hole \_\_\_\_\_

Abandoned \_\_\_\_\_



Map No. **KANSAS** Sec. **26** Twp. **28** R. **5**

Well No. **7** **Bennell**

**Tidal** Company

Contractor

FIRST REPORT

SECTION PLAT

**1120** Ft. from N. Line

----- Ft. from S. Line

----- Ft. from E. Line

**1120** Ft. from W. Line

0			

Location -----

Rig up -----

Drilling and Remarks:

**1600'**

RECORD

Cased ----- in., ----- ft.

Sand -----

Gas -----

Oil -----

Total Depth -----

PRODUCTION

1st 24 hrs. Nat. -----

1st 24 hrs. after shot -----

Gas ----- Cu. Ft.

Dry Hole -----

Abandoned -----

Date **FEB 6** 1923

**M. A. BENEAR**

Map No. **KANSAS** 11 Sec. 26 Twp. 28 R. 5

Well No. 7 Bonnell

Tidal Company

Contractor

# COMPLETED SECTION PLAT

1120 Ft. from N. Line

\_\_\_\_\_ Ft. from S. Line

\_\_\_\_\_ Ft. from E. Line

1120 Ft. from W. Line

0			

Location \_\_\_\_\_

Rig up \_\_\_\_\_

Drilling and Remarks:

*Sand { 275-7'  
          1280-5'*

*Plug Back 270'*

*175 lbs*

*Natural*

## RECORD

Cased \_\_\_\_\_ in., \_\_\_\_\_ ft.

Sand \_\_\_\_\_

Gas \_\_\_\_\_

Oil \_\_\_\_\_

Total Depth \_\_\_\_\_

## PRODUCTION

1st 24 hrs. Nat. \_\_\_\_\_

1st 24 hrs. after shot \_\_\_\_\_

Gas \_\_\_\_\_ Cu. Ft.

Dry Hole \_\_\_\_\_

Abandoned \_\_\_\_\_

Date **MAR 22 1923**

**M. A. BENEAR**

\_\_\_\_\_ 192 \_\_\_\_\_ Scout