

Well No. 8 Bonnell Farm

Lewis Oil Company

WEST

EAST

SOUTH

FIRST REPORT

Drilling Remarks:

PRODUCTION

1st 24 hrs. Nat._____

1st 24 hrs. after shot_____

Gas _____ cu. ft.

Dry Hole _____

Total Depth_____


Abandoned _____

Map No. _____ Sec. 26 Twp. 28 R. 5Well No. 8 Bonnell Farm _____
Lewis Oil Company _____1120 Ft. from N. Line

_____ Ft. from S. Line

660 Ft. from E. Line

_____ Ft. from W. Line

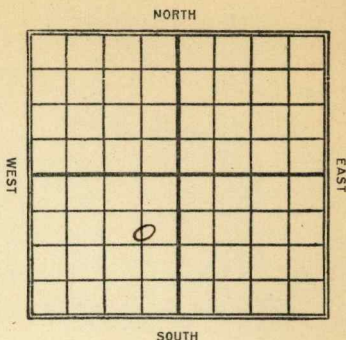

Date

REPORT

192210/26 Rig.19231/6 D4A-2810'

Map No. **KANSAS** 11 Sec. **26** Twp. **28** R. **5**Well No. **2 Bennett****Lewis** Co. Company

Contractor

FIRST REPORT

SECTION PLAT

1120 Ft. from N. Line

Ft. from S. Line

660 Ft. from E. Line

Ft. from W. Line

Location

Rig up

Drilling and Remarks:

Rig

RECORD

Cased _____ in., _____ ft.

Sand _____

Gas _____

Oil _____

Total Depth _____

PRODUCTION

1st 24 hrs. Nat. _____

1st 24 hrs. after shot _____

Gas _____ Cu. Ft.

Dry Hole _____

Abandoned _____

Date

M. A. BENEAR

OCT 26 1922

191

Scout

Map No. **KANSAS** 11 Sec. **26** Twp. **38** R. **5**Well No. **8** **Bennell****Lewis Oil** Company

Contractor

ABANDONED SECTION PLAT**1120** Ft. from N. Line

Ft. from S. Line

660 Ft. from E. Line

Ft. from W. Line

RECORD

Location

Cased _____ in., _____ ft.

Rig up

Sand

Drilling and Remarks:

Gas

Oil

Total Depth

PRODUCTION

1st 24 hrs. Nat.

1st 24 hrs. after shot

Gas _____ Cu. Ft.

Dry Hole

Abandoned **2810**

Date

JAN 6 1923**M. A. BENEAR**

191

Scout