


Map No. **KANSAS** Sec. **10** Twp. **31** R. **10**
Well No. **1 - Town Lot** Farm
Union Gas Corp Company

~~250~~ Ft. from N. Line

1120 Ft. from S. Line

_____ Ft. from E. Line

200
~~250~~ Ft. from W. Line

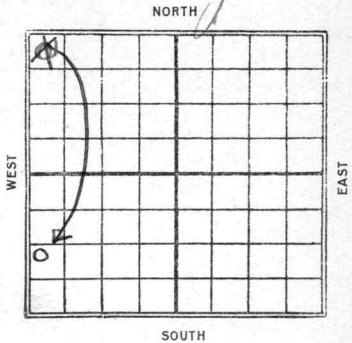

1928

Date

REPORT

5/10	Drilg 300'
5/18	
5/24	Drilg 1400'
5/31	" 1978
6/7	Topline 1987 - Drilg 2005
6/12	1976-2004 T.D. 2004
	Pay 1984-2004
	80/60 bbls

4 KANSAS
 MAP No. _____ SEC. 10 TWP. 31 R. 10
 WELL No. 1 Town Rut
 Union Gas Corp COMPANY

CONTRACTOR

FIRST REPORTS

SECTION PLAT

250 FT. FROM N. LINE
 _____ FT. FROM S. LINE
 _____ FT. FROM E. LINE
 250 FT. FROM W. LINE

0			

LOCATION _____

RIG UP _____

DRILLING AND REMARKS:

slg 300'

RECORD

CASED _____ IN., _____ FT.

SAND _____

GAS _____

OIL _____

TOTAL DEPTH _____

PRODUCTION

1ST 24 HRS. NAT. _____

1ST 24 HRS. AFTER SHOT _____

GAS _____ CU. FT.

DRY HOLE _____

ABANDONED _____

DATE
MAY 10 1928

CHAS. L. SHERWOOD

192

SCOUT

Elk
4 KANSAS
 MAP NO. _____ SEC. 10 TWP. 31 R. 10

WELL NO. 1 *Jawon lot*
Union Gas Corp COMPANY

CONTRACTOR _____

SECTION PLAT

CORRECTION

_____ FT. FROM N. LINE

1170 FT. FROM S. LINE

_____ FT. FROM E. LINE

200 FT. FROM W. LINE

o			
o			

RECORD

LOCATION _____

RIG UP blg 1400

DRILLING AND REMARKS:

Chg location

CASED _____ IN., _____ FT.

SAND _____

GAS _____

OIL _____

TOTAL DEPTH _____

PRODUCTION

1ST 24 HRS. NAT. _____

1ST 24 HRS. AFTER SHOT _____

GAS _____ CU. FT.

DRY HOLE _____

ABANDONED _____

DATE
MAY 24 1928

CHAS. L. SHERWOOD

talk

4 KANSAS

MAP No. _____ SEC. 10 TWP. 31 R. 10

WELL No. 1 *Jayon lat*

Union Gas Corp

COMPANY

CONTRACTOR

COMPLETED

SECTION PLAT

0			

_____ FT. FROM N. LINE
 _____ FT. FROM S. LINE
 _____ FT. FROM E. LINE
 _____ FT. FROM W. LINE

lat 6 - Bls 1

LOCATION _____

RIG UP _____

DRILLING AND REMARKS:

Pay 1984-2004

80760 lbs.

RECORD

CASED _____ IN. _____ FT.
 SAND 1976-2004
 GAS _____
 OIL _____
 TOTAL DEPTH 2004

PRODUCTION

1ST 24 HRS. NAT. _____
 1ST 24 HRS. AFTER SHOT _____
 GAS _____ CU. FT.
 DRY HOLE _____
 ABANDONED _____

DATE

JUN 13 1928

CHAS. L. SHERWOOD

192

SCOUT