


Map No. KANSAS Sec. 10 Twp. 31 R. 10
Well No. 3 Webb Farm
Donor Gas Co. Company

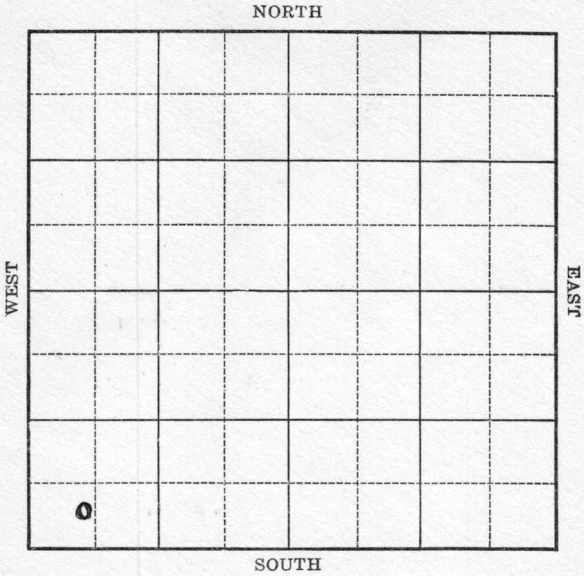

Location _____
Drilling Remarks _____

RECORD

Cased _____ in. _____ ft.
Sand _____
Gas _____
Oil _____
Total Depth _____

Rig Up _____
Drilling Remarks _____

PRODUCTION


1st 24 hrs. Nat. _____
1st 24 hrs. after shot _____
Gas _____ cu. ft.
Dry Hole _____
Abandoned _____

Map No. Kansas Sec. 10 Twp. 31 R. 10Well No. 3 Webb FarmSonner Gas Company

.....Ft. from N. Line

350 Ft. from S. Line

.....Ft. from E. Line

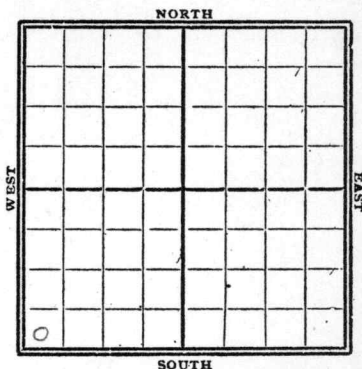600 Ft. from W. Line

Date

REPORT

1928

8/1

Location

8/9

Rigging up

8/16

Spudding 350'

8/23

Drill 1015

8/28

" 1575

9/5

sand 1988-2012

T.O. - 2012

100/100 bbls

Comp

Elk
 4 KANSAS
 MAP No. _____ SEC. 10 TWP. 31 R. 10

WELL No. 3 *Weh*
Sonner Gas Co COMPANY

CONTRACTOR

FIRST REPORTS

SECTION PLAT

0			

Ft. FROM N. LINE

350

Ft. FROM S. LINE

Ft. FROM E. LINE

600

Ft. FROM W. LINE

LOCATION ☒

RIG UP

DRILLING AND REMARKS:

RECORD

CASED _____ IN. _____ FT.

SAND _____

GAS _____

OIL _____

TOTAL DEPTH _____

PRODUCTION

1ST 24 HRS. NAT. _____

1ST 24 HRS. AFTER SHOT _____

GAS _____ CU. FT.

DRY HOLE _____

ABANDONED _____

DATE

AUG 1 1928

CHAS. L. SHERWOOD

192

SCOUT

K4 KANSAS

MAP NO. _____ SEC. 10 TWP. 31 R. 10WELL NO. 3 WebbSonner Gas Co COMPANY

CONTRACTOR _____

COMPLETED

SECTION PLAT

_____ FT. FROM N. LINE

350 FT. FROM S. LINE

_____ FT. FROM E. LINE

600 FT. FROM W. LINE

RECORD

LOCATION _____

CASED _____ IN. _____ FT.

RIG UP _____

SAND 1988-2012

DRILLING AND REMARKS:

GAS _____

OIL _____

TOTAL DEPTH 2012

PRODUCTION

1ST 24 HRS. NAT. _____

1ST 24 HRS. AFTER SHOT _____

GAS _____ CU. FT.

DRY HOLE _____

ABANDONED _____

DATE

SEP 5 1928

CHAS. L. SHERWOOD

192

SCOUT