


Map No. KANSAS Sec. 19 Twp. 31 R. 10
Well No. Webb-Moline Int Farm
Sommer Gas Company

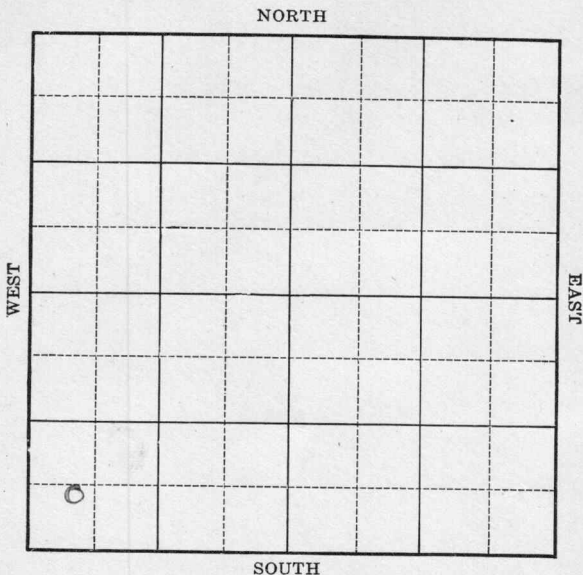

Location _____

Drilling Remarks _____

Rig Up _____

Drilling Remarks _____

RECORD

Cased _____ in. _____ ft.

Sand _____

Gas _____

Oil _____

Total Depth _____

PRODUCTION

1st 24 hrs. Nat. _____

1st 24 hrs. after shot _____

Gas _____ cu. ft.

Dry Hole _____

Abandoned _____

KANSAS

Map No. Sec. 10 Twp. 31 R. 10

Well No. 1 - Webb-Moline ^{Inc} Farm


Sonner Gas Company

_____ Ft. from N. Line

600 Ft. from S. Line

_____ Ft. from E. Line

500 Ft. from W. Line

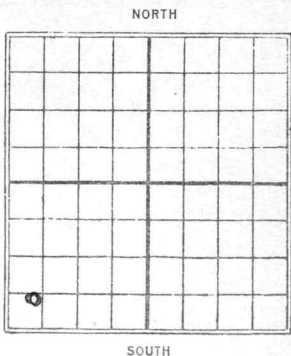

1928

Date

REPORT

Date	REPORT
7/13	Rigging up
7/19	Drlg - 350
7/26	" 750
8/1	Sand 1153-1170
	20 gts 1/2 in Gas

MAP No. Kansas SEC. 10 TWP. 31 R. 10
 K4 1 Webb - Moline Junction
 WELL No. Donner Gas Co COMPANY

CONTRACTOR

SECTION PLAT

FIRST REPORTS

0			

_____ FT. FROM N. LINE
600 FT. FROM S. LINE
 _____ FT. FROM E. LINE
500 FT. FROM W. LINE

LOCATION _____

RIG UP _____

DRILLING AND REMARKS:

rigging up

RECORD

CASED _____ IN. _____ FT.
 SAND _____
 GAS _____
 OIL _____
 TOTAL DEPTH _____

PRODUCTION

1ST 24 HRS. NAT. _____
 1ST 24 HRS. AFTER SHOT _____
 GAS _____ CU. FT.
 DRY HOLE _____
 ABANDONED _____

DATE

7/13/28 192

Sherwood SCOUT

Elk

4 KANSAS

MAP NO. _____ SEC. *10* TWP. *31* R. *10*

WELL No. *1 Well*

Sommer Gas Co

COMPANY

CONTRACTOR

COMPLETED

SECTION PLAT

_____ FT. FROM N. LINE

600

_____ FT. FROM S. LINE

_____ FT. FROM E. LINE

500

_____ FT. FROM W. LINE

LOCATION _____

RIG UP _____

DRILLING AND REMARKS:

207 1/2 ft gas

gas well

RECORD

CASED _____ IN. _____ FT.

SAND *1153-1170*

GAS _____

OIL _____

TOTAL DEPTH *1170*

PRODUCTION

1ST 24 HRS. NAT. _____

1ST 24 HRS. AFTER SHOT _____

GAS *1/2 ft* _____ CU. FT.

DRY HOLE _____

ABANDONED _____

DATE

AUG 1 1928

CHAS. L. SHERWOOD

192

SCOUT