

EEK

Map No. KANSAS Sec. 12 Twp. 31 R. 10^E


Well No. 1- Spray Farm
Frantz et al Company

_____ Ft. from N. Line

250 Ft. from S. Line

1070 Ft. from E. Line

_____ Ft. from W. Line

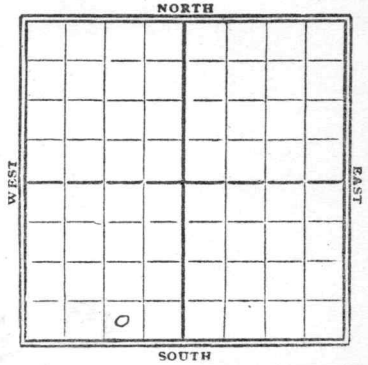

1929

Date

REPORT

5/29	Wrlg 350'
6/15	fsq 680'
6/12	sety 8" - 1410'
6/19	Top line 1948
	only 1978' line
6/26	" 2033'
7/2	" 2280'
7/10	Wilcox sd 2240-68'
	S.D. 2268' HFW 2250
7/17	Top line 1948-2190
	Chlc line 2250-64
	T.D. 2264
	Abandon

Elk

4 **KANSAS** Sec. *17* Twp. *31* R. *10^E*

Well No. *1 Spray*

Trantz et al Company

Contractor

FIRST REPORTS

..... Ft. from N. Line

750 Ft. from S. Line

1070 Ft. from E. Line

..... Ft. from W. Line

SECTION PLAT

Location.....

Rig up.....

Drilling and Remarks:

Dry 350'

RECORD

Cased..... in., ft.

Sand.....

Gas.....

Oil.....

Total Depth.....

PRODUCTION

1st 24 hrs. Nat.....

1st 24 hrs. after shot.....

Gas..... Cu. Ft.

Dry Hole.....

Abandoned.....

Date

MAY 29 1929

..... 192.....

CHAS. L. SHERWOOD

..... Scout

Yelp
12 Twp. 31 R. 10

Map No. _____ Sec. KANSAS Twp. 31 R. 10

Well No. 4 1 Spray

Frantz et al Company

Contractor

COMPLETE

SECTION PLAT

_____ Ft. from N. Line

750 Ft. from S. Line

1070 Ft. from E. Line

_____ Ft. from W. Line

ABANDONED

	0		

Location _____

Rig up _____

Drilling and Remarks:

T. time 1948-2190

Silc line 2250-64

RECORD

Cased _____ in., _____ ft.

Sand _____

Gas _____

Oil _____

Total Depth 2264

PRODUCTION

1st 24 hrs. Nat. _____

1st 24 hrs. after shot _____

Gas _____ Cu. Ft.

Dry Hole

Abandoned

Date

JUL 17 1929

CHAS. L. SHERWOOD