

Sec. 26 Twp. 28 S Range 5 E

36 N. Fox Bush Unit

Kansas Geological Society

Sunray Mid Continent

Skelly Scout Tickets

SEC. **HOT FILE** TWP. 28S R. 5E Dev

WELL NO. 26


#36 N. Fox Bush Unit

FARM

COMPANY

Sunray - Mid-Continent

CONTRACTOR

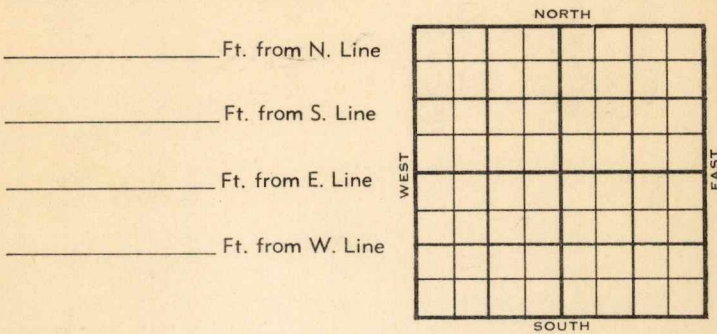

1955	ELEVATION REPORT
7/7	Dlg. 1385' Location and spud date to follow
7/8	Dlg, 1860'
7/11	Dlg. 2225'
7/12	Drilling Location 680' WEL & 650' NSL of Se/4 Spudded 7-2-55 T.D. 2225'
7/13	T.D. 2838' WOC 5 1/2" csg. Cmtd. at 2785'
7/14	T.D. 2838'
7/15	Drilling and cleaning out cement
7/18	T.D. 2838 Prep to PB to 2816'
7/19	PBTD 2816' - Bailed 5 gal water in 6 hrs Rig released 7-17-55
7/20	No report
7/21	" "
7/22	" "
& 7/25	Open hole - 2785-2833 Bartlesville zone Pumped 5 bbls oil & 5 BW/d

COMPLETED