


Map No. 15 Sec. 13 Twp. 31 R. 10

Well No. T-Webb Farm
Pure oil Company

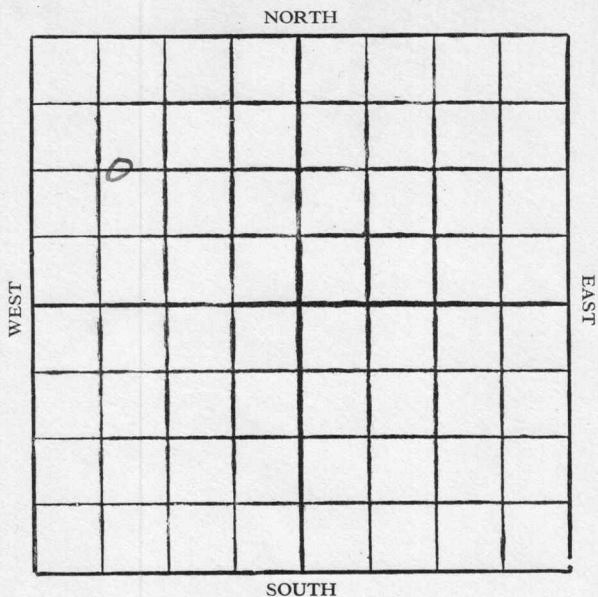

Location

Drilling Remarks

.....

.....

RECORD

Cased..... in. ft.

Sand

Gas

Oil

Total Depth.....

Rig Up.....

Drilling Remarks

.....

.....

PRODUCTION

1st 24 hrs. Nat.....

1st 24 hrs. after shot.....

Gas..... cu. ft.

Dry Hole.....

Abandoned.....

ELK

Map No. Kansas Sec. 13 Twp. 31 R. 10

Well No. 7 Webb Farm


Pure Oil Company

1320 Ft. from N. Line

..... Ft. from S. Line

..... Ft. from E. Line

765 Ft. from W. Line

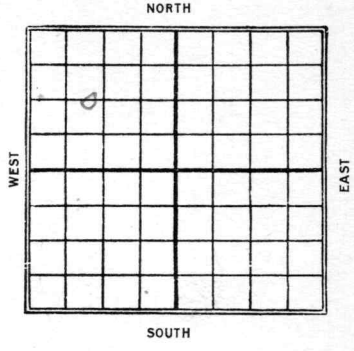

Date

REPORT

1927
1/8

Sand 1313-1345

35 bbls 27 Gravity

4 KANSAS 13 Twp. 31 R. 10^w
 Map No. Sec. Twp. R.
 Well No. 7 Webb
 Lure Oil Co. Company
 Contractor

FIRST REPORTS SECTION PLAT

1320 Ft. from N. Line
 Ft. from S. Line
 Ft. from E. Line
 765 Ft. from W. Line

COMPLETED

Location -----
 Rig up -----
 Drilling and Remarks:

35 lbs.
 37 Gravity

RECORD

Cased _____ in. _____ ft.
 Sand 1313-1345
 Gas -----
 Oil -----
 Total Depth 1345

PRODUCTION

1st 24 hrs. Nat. -----
 1st 24 hrs. after shot -----
 Gas ----- Cu. Ft.
 Dry Hole -----
 Abandoned -----

Date
 JAN 8 1927

CHAS. L. SHERWOOD