

Elko

Map No. *Kansas* Sec. *13* Twp. *31* R. *10*

Well No. *J Webb* Farm


Pure Oil Company

1320 Ft. from N. Line

..... Ft. from S. Line

..... Ft. from E. Line

1320 Ft. from W. Line

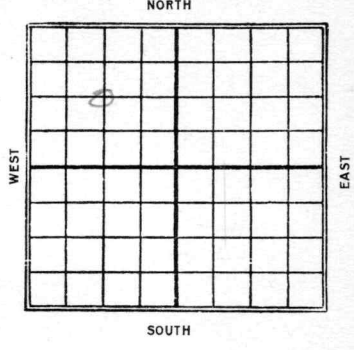

Date

REPORT

1927

1/8

Sand 1308-1320 ?
Abandoned 1420

4 KANSAS
 Map No. _____ Sec. 13 Twp. 31 R. 10
 Well No. 8 Webb
 July O D Co

Company

Contractor

FIRST REPORTS

SECTION PLAT

1320 Ft. from N. Line

_____ Ft. from S. Line

_____ Ft. from E. Line

1320 Ft. from W. Line

COMPLETED

	0		
ABANDONED			

Location _____

Rig up _____

Drilling and Remarks:

RECORD

Cased _____ in. _____ ft.

Sand 1308-1320

Gas _____

Oil _____

Total Depth 1420

PRODUCTION

1st 24 hrs. Nat. _____

1st 24 hrs. after shot _____

Gas _____ Cu. Ft.

Dry Hole

Abandoned

Date

JAN 8 1927

CHAS. L. SHERWOOD

192 _____ Scout