


ELK

Map No. Kansas Sec. 13 Twp. 31 R 10

Well No. 10 Webb Farm

Pure oil Company

NORTH

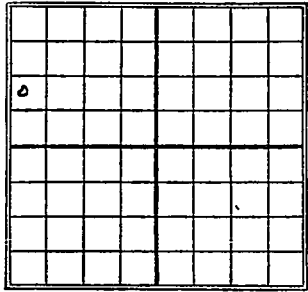

SOUTH

_____ Ft. from N. Line

1055 Ft. from S. Line

_____ Ft. from E. Line

250 Ft. from W. Line

Date
1927

REPORT

1/8 Sand 1615-1627
200 bbls
38 Gravity

Map No. **4 KANSAS** Sec. **13** Twp. **21** R. **10 E**
 Well No. **10 Webb**
W. O. Co Company

Contractor

FIRST REPORTS

SECTION PLAT

_____ Ft. from N. Line
1055 Ft. from S. Line
 _____ Ft. from E. Line
250 Ft. from W. Line

o			

COMPLETED

Location _____
 Rig up _____

Drilling and Remarks:
200 lbs.
38 Gravity.

RECORD

Cased _____ in., _____ ft.
 Sand **1615-1627**
 Gas _____
 Oil _____
 Total Depth **1627**

PRODUCTION

1st 24 hrs. Nat. _____
 1st 24 hrs. after shot _____
 Gas _____ Cu. Ft.
 Dry Hole _____
 Abandoned _____

Date **JAN 8 1927** **CHAS. L. SHERWOOD**
 _____ 192 _____ Scout