



Map No. Kansas Sec. 14 Twp. 31 R. 10


Well No. 6 Chaffin Farm  
Pure Oil Company

200 Ft. from N. Line

\_\_\_\_\_ Ft. from S. Line

\_\_\_\_\_ Ft. from E. Line

660 Ft. from W. Line

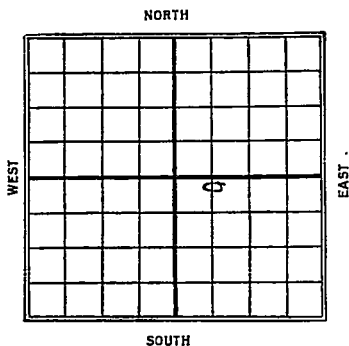

Date

REPORT

1927

1/8 Sand 1348-1364 T.D. 1365  
25 bbls

4 KANSAS Sec 14 Twp. 31 R. 10 E  
 Well No. 6 Chapman  
 Rule Oil Co. Company

Contractor

FIRST REPORTS

SECTION PLAT

200 Ft. from N. Line  
 \_\_\_\_\_ Ft. from S. Line  
 \_\_\_\_\_ Ft. from E. Line  
 660 Ft. from W. Line

		0	

COMPLETED

Location \_\_\_\_\_  
 Rig up \_\_\_\_\_  
 Drilling and Remarks:

85 lbs.

RECORD

Cased \_\_\_\_\_ in., \_\_\_\_\_ ft.  
 Sand 1348-1364  
 Gas \_\_\_\_\_  
 Oil \_\_\_\_\_  
 Total Depth 1365

PRODUCTION

1st 24 hrs. Nat. \_\_\_\_\_  
 1st 24 hrs. after shot. \_\_\_\_\_  
 Gas \_\_\_\_\_ Cu. Ft.  
 Dry Hole \_\_\_\_\_  
 Abandoned \_\_\_\_\_

Date

JAN 8 1927

CHAS. L. SHERWOOD

192

Scout